

MISSISSIPPI DEPARTMENT OF ENVIRONMENTAL QUALITY
Bureau of Land and Water Resources

P. O. Box 10631
Jackson, MS 39289-0631
WATER WELL DRILLERS LOG

COUNTY WELL LOCATED JACKSON	
WELL NUMBER L2074	CODED
DATE WELL COMPLETED 8-13-91	

PERMIT NUMBER
NAME OF DRILLING FIRM <i>Coast Water Well, Inc.</i>

NAME & MAILING ADDRESS OF LANDOWNER <i>Wayne Dawson</i>			
WELL LOCATION: SEC <u>15</u> TOWNSHIP <u>6</u> RANGE <u>6E</u>			
DISTANCE <u>1</u> Miles	DIRECTION <u>SE</u>	NEAREST TOWN <u>VAN Cleave</u>	
OTHER LANDMARK			
WELL PURPOSE: <u>Home</u> Irrigation, Municipal, Industrial, Fish Pond, etc.			

PUMP DATA		
PUMP TYPE (Circle One): Submersible, Turbine, <u>Jet</u> Flowing Well, Other (Describe) _____		
POWER TYPE (Circle One): <u>Electric</u> , Tractor, Diesel, Gasoline, Butane, Other (Describe) _____ H/P <u>1 1/2"</u>		
Pump Capacity (GPM) <u>7</u>	No. of Stages <u>2</u>	Setting Depth <u>80</u> FT.
PUMP TEST Well yielded _____ GPM with a drawdown of _____ ft. after _____ hours of pumping		

WELL DATA		
Well Depth <u>462'</u>	Casing Diameter (In.) <u>2"</u>	Casing Length (Ft.) <u>452'</u>
Type of Casing <u>PVC</u>	Hole Depth <u>466'</u>	Depth to Static Water Level <u>60'</u>
TYPE OF COMPLETION: (Circle One or More): Gravel Packed, Underreamed, Telescoped, Natural Development, Open Hole, Other (Describe) _____		
Top of Lap Pipe or Reduction in Casing <u>FEET</u> IF TELESCOPED OR MORE THAN ONE SCREEN: USE BACK PAGE		

LOG DATA	
TYPE OF LOG RUN (Circle One): Electric, Gamma Ray, Density, Sonic, Neutron, Other (Describe) _____ <u>No Log Run</u>	
Name of Organization Running Log	

SCREEN DATA		
Diameter - Inches <u>2"</u>	Length - Feet <u>10</u>	Slot Size - Inches <u>.008</u>
Screen Type <u>PVC</u>	Depth to Bottom - Feet <u>462'</u>	

GEOLOGIC DATA (Office Use Only)			
Surface Elev.	Geologic Unit	Unit Thickness	Depth to Top
Subs. SWL	Date	Analysis	Aquifer Test
Driller's Remarks			

DESCRIPTION OF FORMATIONS ENCOUNTERED	FROM	TO	FORMATIONS (Continued)	FROM	TO
<i>top soil</i>	<i>0</i>	<i>2</i>			
<i>yellow clay</i>	<i>2</i>	<i>15</i>			
<i>med. sand</i>	<i>15</i>	<i>25</i>			
<i>gray clay</i>	<i>25</i>	<i>55</i>			
<i>coarse sand</i>	<i>55</i>	<i>75</i>			
<i>gray clay</i>	<i>75</i>	<i>100</i>			
<i>coarse sand</i>	<i>100</i>	<i>130</i>			
<i>blue clay</i>	<i>130</i>	<i>209</i>			
<i>fine sand</i>	<i>209</i>	<i>214</i>			
<i>blue clay 2' of sand</i>	<i>214</i>	<i>435</i>			
<i>coarse sand</i>	<i>435</i>	<i>466</i>			

RECEIVED


OCT 09 1991

Dept. of Environmental Quality
Bureau of Land & Water Resources

IF MORE SPACE IS NEEDED, USE BACK

If well telescopes please sketch and show depths:

GROUND LEVEL

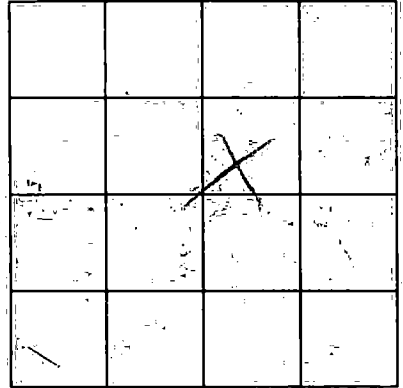

SECTION _____

Please indicate well location X.

ADDITIONAL INFORMATION

Horizontal lines for providing additional information.

DEWEY

If more than one screen, show location of each on sketch.