

MISSISSIPPI DEPARTMENT OF ENVIRONMENTAL QUALITY
Bureau of Land and Water Resources

P. O. Box 10631
Jackson, MS 39289-0631
WATER WELL DRILLERS LOG

COUNTY WELL LOCATED <i>Jackson</i>	
WELL NUMBER <i>22079</i>	CODED
DATE WELL COMPLETED <i>7-21-92</i>	

PERMIT NUMBER
NAME OF DRILLING FIRM <i>Coast Water Well Serv Inc</i>

NAME & MAILING ADDRESS OF LANDOWNER <i>Bruce Dentloff</i>			
WELL LOCATION: SEC <i>13</i> TOWNSHIP <i>60^N</i> RANGE <i>6^{EW}</i>			
DISTANCE <i>6</i> Miles	DIRECTION <i>North</i>	NEAREST TOWN <i>Eastover</i>	
OTHER LANDMARK			
WELL PURPOSE: Home, Irrigation, Municipal, Industrial, Fish Pond, etc. <i>Irrigation</i>			

PUMP DATA		
PUMP TYPE (Circle One): Submersible, Turbine, Jet , Flowing Well, Other (Describe)		
POWER TYPE (Circle One): Electric , Tractor, Diesel, Gasoline, Butane, Other (Describe) H/P <i>1/2</i>		
Pump Capacity (GPM) <i>6</i>	No. of Stages <i>1</i>	Setting Depth <i> </i> FT.
PUMP TEST		
Well yielded <i> </i> GPM with a drawdown of <i> </i> ft. after <i> </i> hours of pumping		

WELL DATA		
Well Depth <i>70'</i>	Casing Diameter (In.) <i>20</i>	Casing Length (Ft.) <i>60'</i>
Type of Casing <i>PVC</i>	Hole Depth <i>70'</i>	Depth to Static Water Level <i>20'</i>
TYPE OF COMPLETION: (Circle One or More): Natural Development , Gravel Packed, Underreamed, Telescoped, Open Hole, Other		
Top of Lap Pipe or Reduction in Casing FEET IF TELESCOPED OR MORE THAN ONE SCREEN: USE BACK PAGE		

LOG DATA	
TYPE OF LOG RUN (Circle One): Electric, Gamma Ray, Density, Sonic, Neutron, Other (Describe) No Log Run	
Name of Organization Running Log	

SCREEN DATA		
Diameter - Inches <i>2"</i>	Length - Feet <i>10'</i>	Slot Size - Inches <i>.008</i>
Screen Type <i>PVC</i>	Depth to Bottom - Feet <i>70'</i>	


GEOLOGIC DATA (Office Use Only)			
Surface Elev.	Geologic Unit	Unit Thickness	Depth to Top
Subs. SWL	Date	Analysis	Aquifer Test
Driller's Remarks			

DESCRIPTION OF FORMATIONS ENCOUNTERED	FROM	TO
<i>Topsoil</i>	<i>0</i>	<i>2</i>
<i>Yellow clay</i>	<i>2</i>	<i>18</i>
<i>Blue clay</i>	<i>18</i>	<i>50</i>
<i>Coarse sand/gravel</i>	<i>50</i>	<i>70</i>

RECEIVED	
OCT 07 1992	
Dept. of Environmental Quality Bureau of Land & Water Resources	
IF MORE SPACE IS NEEDED, USE BACK	

If well telescopes please sketch and show depths:

GROUND LEVEL

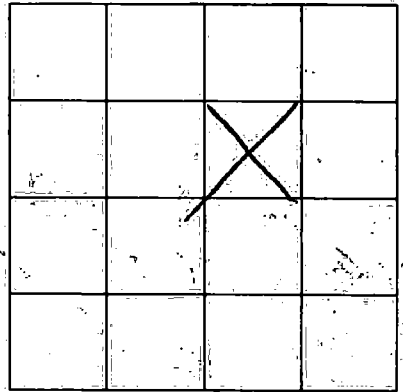

SECTION _____

Please indicate well location X.

ADDITIONAL INFORMATION

Multiple horizontal lines for writing additional information.

If more than one screen, show location of each on sketch.

RECEIVED

UNITED STATES DEPARTMENT OF THE INTERIOR
BUREAU OF LAND MANAGEMENT