

MISSISSIPPI DEPARTMENT OF ENVIRONMENTAL QUALITY

Office of Land and Water Resources

P. O. Box 10631
Jackson, MS 39289-0631

WATER WELL DRILLERS LOG

COUNTY WELL LOCATED <i>Jackson</i>	
WELL NUMBER <i>2113</i>	CODED
DATE WELL COMPLETED <i>6-11-99</i>	

PERMIT NUMBER
NAME OF DRILLING FIRM <i>Coastal Well Service</i>

NAME & MAILING ADDRESS OF LANDOWNER <i>Ricky Moore Summerlin Bayou Rd Vandevue, Ms.</i>			
WELL LOCATION:	SEC	TOWNSHIP	RANGE
	<i>40</i>	<i>6 S</i>	<i>6 W</i>
DISTANCE	DIRECTION	NEAREST TOWN	
<i>4</i> Miles	<i>SE</i>	of <i>Vandevue</i>	
OTHER LANDMARK			
WELL PURPOSE: Home, Irrigation, Municipal, Industrial, Fish Pond, etc. <i>FOX PEN</i>			

PUMP DATA		
PUMP TYPE (Circle One): Submersible, Turbine, <input checked="" type="radio"/> Jet, Flowing Well, Other (Describe) _____		
POWER TYPE (Circle One): <input checked="" type="radio"/> Electric, Tractor, Diesel, Gasoline, Butane, Other (Describe) _____		
Pump Capacity (GPM) <i>8</i>	No. of Stages <i>2</i>	Setting Depth _____ FT.
PUMP TEST		
Well yielded _____ GPM with a drawdown of _____ ft. after _____ hours of pumping		

WELL DATA		
Well Depth <i>55'</i>	Casing Diameter (in.) <i>2"</i>	Casing Length (ft.) <i>45'</i>
Type of Casing <i>PVC</i>	Hole Depth <i>55'</i>	Depth to Static Water Level <i>20'</i>

LOG DATA	
TYPE OF LOG RUN (Circle One): Electric, Gamma Ray, Density, Sonic, <input checked="" type="radio"/> No Log Run, Neutron, Other (Describe) _____	
Name of Organization Running Log	

TYPE OF COMPLETION: (Circle One or More): <input checked="" type="radio"/> Gravel Packed, <input type="radio"/> Underreamed, <input type="radio"/> Telescoped, <input checked="" type="radio"/> Natural Development, <input type="radio"/> Open Hole, <input type="radio"/> Other	
WELL GROUTED TO A DEPTH OF <i>40</i> FEET Type Grout (circle one): Cement, Bentonite, or Mix	

GEOLOGIC DATA (Office Use Only)			
Surface Elev.	Geologic Unit	Unit Thickness	Depth to Top
Subs. SWL	Date	Analysis	Aquifer Test

SCREEN DATA		
Diameter - Inches <i>2"</i>	Length - Feet <i>10'</i>	Slot Size - Inches <i>.008</i>
Screen Type <i>PVC</i>	Depth to Bottom - Feet <i>55'</i>	


Driller's Remarks	
Top of Lap Pipe or Reduction in Casing	
FEET	IF TELESCOPED OR MORE THAN ONE SCREEN: USE BACK PAGE

DESCRIPTION OF FORMATIONS ENCOUNTERED	FROM	TO
<i>Top Soil</i>	<i>0</i>	<i>2</i>
<i>W. fine Coars. sand</i>	<i>2</i>	<i>30</i>
<i>Blue Clay</i>	<i>30</i>	<i>40</i>
<i>gray Coars. sand</i>	<i>40</i>	<i>55</i>

FORMATIONS (Continued)	FROM	TO
RECEIVED		
JUL 09 1999		
Dept. of Environmental Quality Office of Land & Water Resources		
IF MORE SPACE IS NEEDED, USE BACK		

If well telescopes please sketch and show depths.

GROUND LEVEL

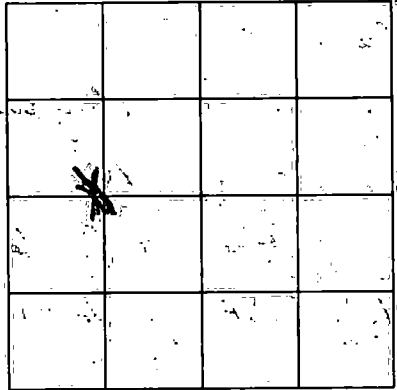

SECTION 40

Please indicate well location X.

ADDITIONAL INFORMATION

RECEIVED
JUL 9 1988

Also show relative to top of well screen
If more than one screen, show location of each on sketch.