

**MISSISSIPPI DEPARTMENT OF ENVIRONMENTAL QUALITY**  
**Office of Land and Water Resources**

P. O. Box 10631  
 Jackson, MS 39289-0631  
**WATER WELL DRILLERS LOG**

COORDED WELL LOCATED  
**JACKSON**

WELL NUMBER  
**L-2134**

CODED

DATE WELL COMPLETED  
**4-19-01**

PERMIT NUMBER

NAME OF DRILLING FIRM  
**Coast Water Well Service**

NAME & MAILING ADDRESS OF LANDOWNER  
**Wayne Meadows**  
**Lampkin Rd.**  
**Moss Point, Ms**

WELL LOCATION: SEC **2** TOWNSHIP **6<sup>th</sup>** RANGE **6<sup>th</sup>**

DISTANCE **4** Miles DIRECTION **NW** NEAREST TOWN **Helena**

OTHER LANDMARK

WELL PURPOSE (Circle one)  Rental **TLRS**  
 Irrigation, Municipal, Industrial, Fish Pond, etc.

**PUMP DATA**

PUMP TYPE (Circle One):  
 Submersible, Turbine,  Flowing Well,  
 Other (Describe) \_\_\_\_\_

POWER TYPE (Circle One):  
 Electric, Tractor, Diesel, Gasoline, Butane,  
 Other (Describe) \_\_\_\_\_ H/P **1**

Pump Capacity (GPM) **10** No. of Stages **2** Setting Depth \_\_\_\_\_ FT.

PUMP TEST  
 Well yielded \_\_\_\_\_ GPM with  
 a drawdown of \_\_\_\_\_ ft.  
 after \_\_\_\_\_ hours of pumping

**WELL DATA**

Well Depth <b>84'</b>	Casing Diameter (In.) <b>2"</b>	Casing Length (Ft.) <b>74'</b>
Type of Casing <b>PVC</b>	Hole Depth <b>84'</b>	Depth to Static Water Level <b>17'</b>

**LOG DATA**

TYPE OF LOG RUN (Circle One):  
 No Log Run,  
 Electric, Gamma Ray, Density, Sonic, Neutron,  
 Other (Describe) \_\_\_\_\_

Name of Organization Running Log

TYPE OF COMPLETION: (Circle One or More):  
 Gravel Packed,  Underreamed,  Telescoped,  
 Natural Development,  Open Hole,  Other

WELL GROUTED TO A DEPTH OF **10** FEET  
 Type Grout (circle one):  Cement,  Bentonite, or Mix

**GEOLOGIC DATA (Office Use Only)**

Surface Elev.	Geologic Unit	Unit Thickness	Depth to Top
Subs. SWL	Date	Analysis	Aquifer Test

Driller's Remarks

Top of Lap Pipe or Reduction in Casing

FEET  IF TELESCOPED OR MORE THAN ONE SCREEN; USE BACK PAGE

**SCREEN DATA**

Diameter - Inches <b>2"</b>	Length - Feet <b>10'</b>	Slot Size - Inches <b>.008</b>
Screen Type <b>PVC</b>	Depth to Bottom - Feet <b>84'</b>	

DESCRIPTION OF FORMATIONS ENCOUNTERED	FROM	TO
<b>White, Orange &amp; Gray Clay</b>	<b>0</b>	<b>47</b>
<b>White Coarse Sand</b>	<b>47</b>	<b>84</b>

**RECEIVED**


**JUN 28 2001**

Dept. of Environmental Quality  
 Office of Land & Water Resources

IF MORE SPACE IS NEEDED, USE BACK

If well telescopes please sketch and show depths.

GROUND LEVEL

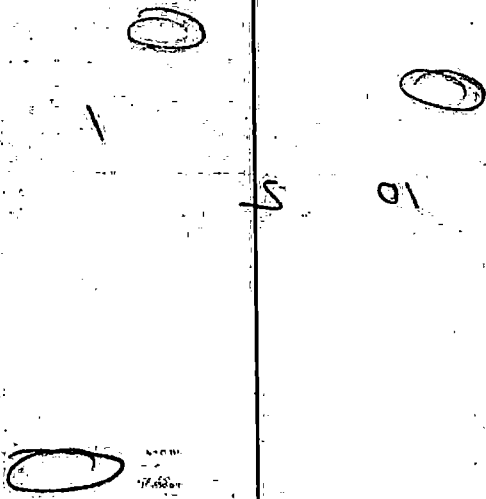


*Handwritten notes on the table grid:*  
 - Top row: "L. ..."

SECTION 2

Please indicate well location X.

ADDITIONAL INFORMATION

Multiple horizontal lines for providing additional information.

If more than one screen, show location of each on sketch.