

JACKSON MISSISSIPPI BOARD OF WATER COMMISSIONERS

M 20  
8-31-60

WATER WELL DRILLERS LOG

~~1142~~

Colville

Date: 8/31, 1960, Driller: Water Supply Co County JACKSON

(Name)

3 R  
Harris Wilcox Timber Co

(1) Owner of Land: \_\_\_\_\_

(Name)

LYONS LAKE Helena Miss

(Address)

(2) Location: NE 1/4, NE 1/4, Sec. 23 T6W R5W

4 miles NE of Helena

(distance)

(direction)

(Nearest Town)

(3) Topography: \_\_\_\_\_

(Hilly)

(Flat)

(Level)

(4) Purpose of Well: \_\_\_\_\_

Domestic Irrigation  
 Municipal, Industrial, Other

Description & Color of Materials Sand, Clay, Red Clay, Shell, etc.		Thick- ness Feet	Depth Feet
depth	FORM	depth	FORM
0	Hard clay	21	Soft Mud
55	SAND	73	Mud
110	SAND	115	Mud
160	STREAKS	164	SAND
172	CLAY	189	SAND
249	CLAY	290	SAND
294	CLAY BLEB	298	SAND
310			

Information upon completion of well:

(1) Diameter 2 inches.

(2) Total Depth 310 feet.

(3) Water Level 12' 6" above feet below top of ground.

(4) Cased to \_\_\_\_\_, Size \_\_\_\_\_

(5) Screen: Size 2", Length 10'

(6) Were any formations sealed against pollution?

yes, no.


If YES depth of formation \_\_\_\_\_

Why \_\_\_\_\_

Drillers Remarks:

This well flows  
real good

Total Depth  
310'

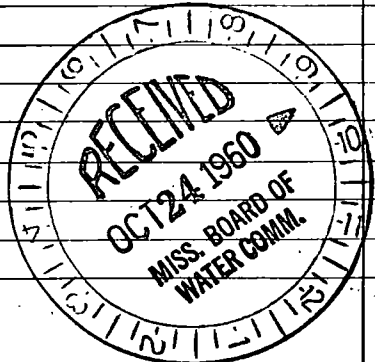

(Use Back Side)

Well No. 2

