

M 28  
9-5-60

**WATER WELL DRILLERS LOG**

Date: 9/5, 1960, Driller: Colville Water Supply Co County JACKSON  
34

(Name)

(1) Owner of Land: Luther Williams  
(Name)  
Helena Miss  
(Address)

(2) Location: NE 1/4, SW 1/4, Sec. 28 T69R5W  
\_\_\_\_ miles \_\_\_\_\_ of \_\_\_\_\_  
(distance) (direction) (Nearest Town)

(3) Topography: \_\_\_\_\_  
(Hilly) (Flat) (Level)

(4) Purpose of Well: \_\_\_\_\_  
 Domestic Irrigation  
Municipal, Industrial, Other

Description & Color of Materials Sand, Clay, Red Clay, Shell, etc.		Thick- ness Feet	Depth Feet
0	yellow clay	21	SAND
53	Mud	75	SAND
84	Streaks	140	Mud
180	Sand	183	Mud
189	Sand	195	Mud
210	Fine sand	231	SAND
252			

Total Depth 252

Information upon completion of well:

(1) Diameter: 1 1/4 inches.

(2) Total Depth: 252 feet.

(3) Water Level: + 1' feet above  below top of ground.

(4) Cased to \_\_\_\_\_, Size \_\_\_\_\_.


(5) Screen: Size 1 1/4, Length 10'.

(6) Were any formations sealed against pollution?  
\_\_\_\_\_ yes, \_\_\_\_\_ no.

If YES depth of formation \_\_\_\_\_

Why \_\_\_\_\_

Drillers Remarks: \_\_\_\_\_

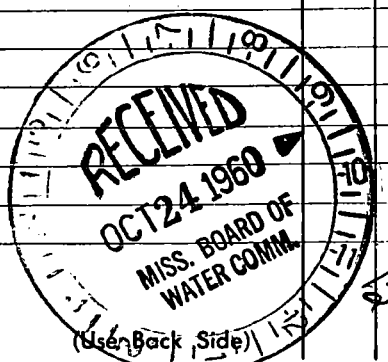

Well No. 34

