

4 0

MISSISSIPPI
 BOARD OF WATER COMMISSIONERS
 416 North State Street
 Jackson, Mississippi 39201

WATER WELL DRILLERS LOG

Jackson
 M29
 11-63

Nov 12 1963 date well completed
 Acville water supply firm name
 Jackson county well located

LANDOWNER: Robert Whalley
Whalley
Helena, Miss
 (mailing address)

description of formations encountered	from	to
Sand	0	84
Clay	84	134
Sand	136	152

WELL LOCATION:
 sec. 3 T. 6 N. R. 5 E.
5 miles NE of Meridian
 (distance) (direction) (nearest town)

WELL PURPOSE: Home
 (home, irrigation, municipal, industrial)

WELL COMPLETION DATA:


- (1) diameter (inches) 2 1/2
- (2) total depth (feet) 152
- (3) static water level (feet) 10 ^{below} ~~above~~ top of ground.
- (4) casing _____ (material), _____ (depth), _____ (size) if telescope see back.
- (5) screen 15 _____, 147 _____ (length) (depth to top)
2 _____, Stainless _____ (size) (material)
- (6) pump _____ (HP) _____ (yield gpm)
 _____ (type power)
- (7) electric log no _____ (yes or no)
 _____ (organization running log)
- (8) how well bottom plugged BRP

DRILLERS REMARKS:



If well telescopes please sketch and show depths.

GROUND LEVEL

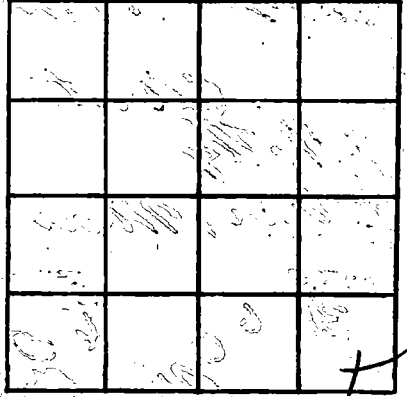

SECTION 31

Please indicate well location X.

ADDITIONAL INFORMATION

If more than one screen, show locations of each on sketch.