

JACKSON MISSISSIPPI BOARD OF WATER COMMISSIONERS

M 38

3-29-62

WATER WELL DRILLERS LOG

Date: 3/29, 1962, Driller: Colville County Jackson
(Name)

	Description & Color of Materials Sand, Clay, Red Clay, Shell, etc.	Thick- ness Feet	Depth Feet
(1) Owner of Land: <u>R Carpenter</u> <small>(Name)</small> <u>Helena</u> <small>(Address)</small>			
(2) Location: <u>SE 1/4, NE 1/4, Sec 32 T6SR5N</u> <u>5 miles North</u> of <u>Escatawpa</u> <small>(distance) (direction) (Nearest Town)</small>			
(3) Topography: <input checked="" type="checkbox"/> <u>Level</u> <small>(Hilly) (Flat) (Level)</small>	<u>Depth Form</u>	<u>Depth</u>	<u>Form</u>
(4) Purpose of Well: <u>Domestic</u> <small>(Domestic Irrigation Municipal, Industrial, Other)</small>	<u>0 Clay 21 Sand</u>	<u>168</u>	<u>Sand</u>
	<u>178</u>		


Information upon completion of well:

- (1) Diameter 1 1/4 inches.
- (2) Total Depth 178 feet.
- (3) Water level 6 feet below top of ground.
- (4) Cased to _____, Size _____.
- (5) Screen: Size 1 1/4, Length 10.
- (6) Were any formations sealed against pollution?
 _____ yes, _____ no.

If YES depth of formation _____

Why _____

Drillers Remarks: _____

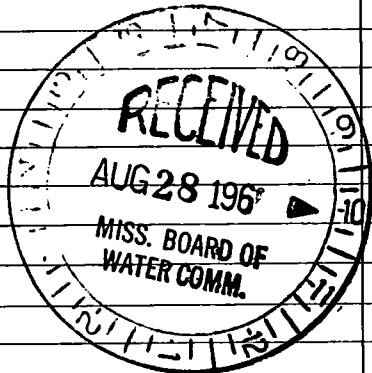

(Use Back Side)

Well No. 178

[The page contains extremely faint and illegible text, likely bleed-through from the reverse side of the document. No specific words or phrases can be reliably transcribed.]