

# JACKSON MISSISSIPPI BOARD OF WATER COMMISSIONERS

M 40

5-17-62


## WATER WELL DRILLERS LOG

Date: 5/17, 1962, Driller: COLVILLE County JACKSON

40

(Name)

	Description & Color of Materials Sand, Clay, Red Clay, Shell, etc.	Thick- ness Feet	Depth Feet
(1) Owner of Land: <u>CAYLTON VICE</u> (Name) <u>HELENA</u> (Address)			
(2) Location <u>SW 1/4, SE 1/4, Sec. 29 T6R5W</u> <u>5</u> miles <u>North</u> , of <u>Escatawpa</u> (distance) (direction) (Nearest Town)			
(3) Topography: <input checked="" type="checkbox"/> (Level) (Hilly) (Flat) (Level)	<u>Depth Form</u> <u>Depth Form</u>		
(4) Purpose of Well: (Domestic Irrigation Municipal, Industrial, Other)	<u>0 Sand 63 Clay</u> <u>155 Sand 178 IR</u>		
Information upon completion of well:			
(1) Diameter <u>1 1/4</u> inches.			
(2) Total Depth <u>178</u> feet.			
(3) Water Level <u>9</u> feet below top of ground.			
(4) Cased to _____, Size _____			
(5) Screen: Size <u>1 1/4</u> , Length <u>10</u>			
(6) Were any formations sealed against pollution? _____ yes, _____ no. <input checked="" type="checkbox"/>			
If YES depth of formation _____			
Why _____			
Drillers Remarks: _____			

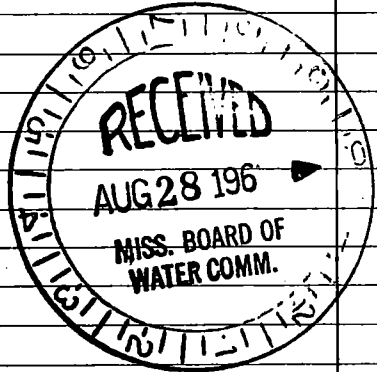

(Use Back Side)

Well No. 40

