

JACKSON

MISSISSIPPI BOARD OF WATER COMMISSIONERS

M 41

WATER WELL DRILLERS LOG

6-1-62

Date: 6-1, 1962, Driller: George Colville, County Jackson

49

(Name)

	Description & Color of Materials Sand, Clay, Red Clay, Shell, etc.	Thick- ness Feet	Depth Feet
(1) Owner of Land: J.C. Cox <del>Mr. Helms</del> (Name) <del>Helms</del> , Miss. (Address)	sandy clay	30	30
(2) Location: NE 1/4, NE 1/4, Sec. 29 T6R5W	white sand	10	40
2600 ft 4 miles NE of Escatawpa (distance) (direction) (Nearest Town)			
(3) Topography: FLAT (Hilly) (Flat) (Level)			
(4) Purpose of Well: Domestic (Domestic Irrigation Municipal, Industrial, Other)			


Information upon completion of well:

- (1) Diameter 1 1/4 inches.
- (2) Total Depth 40 feet.
- (3) Water Level 10 feet below top of ground.
- (4) Cased to \_\_\_\_\_, Size \_\_\_\_\_.
- (5) Screen: Size 80 mesh, Length 5.
- (6) Were any formations sealed against pollution?  
\_\_\_\_\_ yes,  no.

If YES depth of formation \_\_\_\_\_

Why \_\_\_\_\_

Drillers Remarks: \_\_\_\_\_

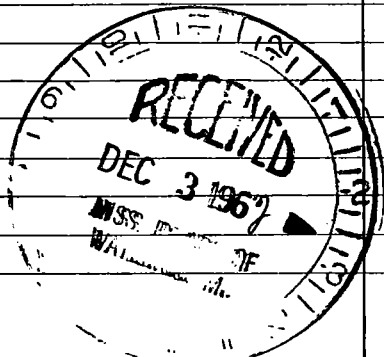

(Use Back Side)

Well No. 137

