

# JACKSON MISSISSIPPI BOARD OF WATER COMMISSIONERS

M 42

## WATER WELL DRILLERS LOG

8-22-62

Date: 8-24, 1962, Driller: George Colville County: Jackson

4 Q

(Name)

(1) Owner of Land:	Description & Color of Materials Sand, Clay, Red Clay, Shell, etc.	Thick- ness Feet	Depth Feet
(Name) <u>A. D. KINNEAN</u> <u>Helena, Miss.</u> (Address)	<u>Yellow, sandy Clay</u>	<u>10</u>	<u>10</u>
(2) Location: <u>NE 1/4, NE 1/4, Sec. 29 T6S R5W</u>	<u>sand</u>	<u>58</u>	<u>68</u>
<u>10</u> miles <u>NE</u> of <u>Escatawpa</u> (distance) (direction) (Nearest Town)	<u>Clay</u>	<u>32</u>	<u>100</u>
(3) Topography: <u>Flat</u>	<u>sand</u>	<u>110</u>	<u>210</u>
(4) Purpose of Well: <u>Domestic</u>	<u>Clay</u>	<u>10</u>	<u>220</u>
(Domestic Irrigation Municipal, Industrial, Other)	<u>sand</u>	<u>32</u>	<u>252</u>


Information upon completion of well:

- (1) Diameter 1 1/4 inches.
- (2) Total Depth 252 feet.
- (3) Water Level 14 feet below top of ground.
- (4) Cased to \_\_\_\_\_, Size \_\_\_\_\_
- (5) Screen: Size 80 mesh, Length 10'
- (6) Were any formations sealed against pollution?  
 \_\_\_\_\_ yes,  no.

If YES depth of formation \_\_\_\_\_

Why \_\_\_\_\_

Drillers Remarks: \_\_\_\_\_

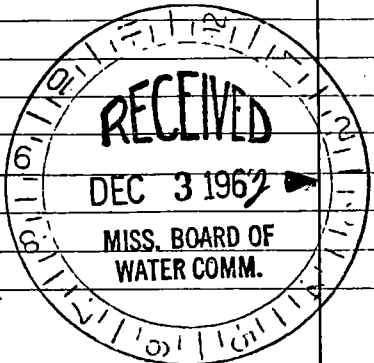

(Use Back Side)

Well No. 142

