

49

JACKSON
M 43
2-63

MISSISSIPPI
BOARD OF WATER COMMISSIONERS
416 North State Street
Jackson, Mississippi 39201

WATER WELL DRILLERS LOG

Feb 25 1963 Colville Water Supply JACKSON
date well completed firm name county well located

LANDOWNER: H.O. Creel

Escatawpa, Miss
(mailing address)

WELL LOCATION:

sec. 28 T 6 N R 5 E
4.5 miles N of Escatawpa
(distance) (direction) (nearest town)

WELL PURPOSE: home
(home, irrigation, municipal, industrial)

WELL COMPLETION DATA:

(1) diameter (inches) 1 1/4
(2) total depth (feet) 225
(3) static water level (feet) 1'-4" below above top of ground.

(4) casing Pipe 215
(material) (depth)
1 1/4 (size) If telescope see back.

(5) screen 10' 215
(length) (depth to top)
1 1/4 BRASS
(size) (material)


(6) pump
(HP) (yield gpm)
(type power)

(7) electric log No
(yes or no)
(organization running log)

(8) how well bottom plugged B.P. Valve

description of formations encountered	from	to
CLAY	0	20
SAND	20	34
CLAY	34	70
SAND	70	73
CLAY	73	89
SAND	89	150
CLAY	150	177
SAND	177	182
CLAY	182	189
SAND	189	205


DRILLERS REMARKS:

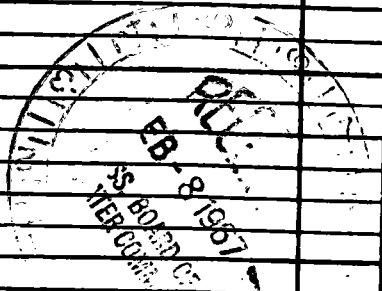

If well telescopes please sketch and show depths.

GROUND LEVEL

NW SE

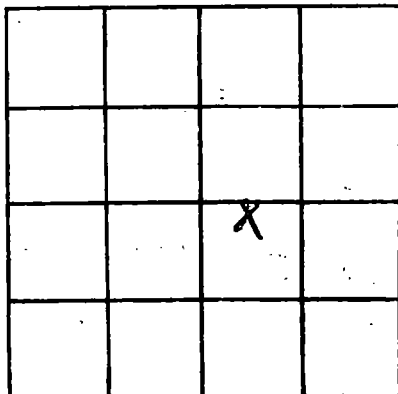

SECTION 28

Please indicate well location X.

ADDITIONAL INFORMATION

If more than one screen, show locations of each on sketch.