

4 Q

Jackson

M 44

3-63

MISSISSIPPI
 BOARD OF WATER COMMISSIONERS
 416 North State Street
 Jackson, Mississippi 39201

WATER WELL DRILLERS LOG

MARCH 11 1963 Cotuille Water Supply Jackson
 date well completed firm name county well located

LANDOWNER: Carl Vice

description of formations encountered

from to

Escatawpa, Miss.
(mailing address)

WELL LOCATION:


sec. 32 T. 6 N. R. 5 E
4.5 miles N of Escatawpa
 (distance) (direction) (nearest town)

WELL PURPOSE: HOME
(home, irrigation, municipal, industrial)

WELL COMPLETION DATA:

- (1) diameter (inches) 1 1/2
- (2) total depth (feet) 168
- (3) static water level (feet) 6-10 ^{below} above top of ground.
- (4) casing Pipe, 163
(material) (depth)
1 1/2 if telescope see back.
(size)
- (5) screen 5 ft., 163
(length) (depth to top)
1 1/2, BRASS
(size) (material)
- (6) pump _____ (HP) _____ (yield gpm)
(type power)
- (7) electric log NO
(yes or no)
(organization running log)
- (8) how well bottom plugged BPV & Lve


DRILLERS REMARKS:

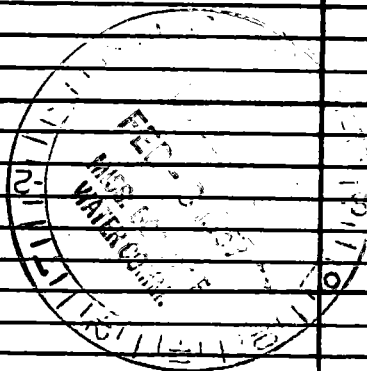

If well telescopes please sketch and show depths.

GROUND LEVEL

SW NE

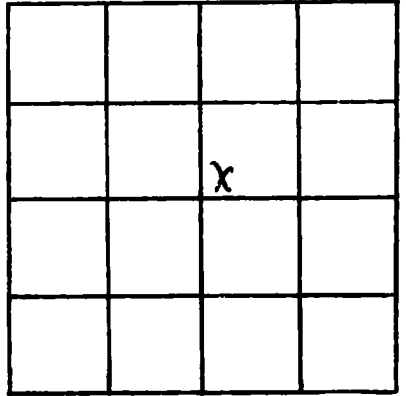

SECTION 32

Please indicate well location X.

ADDITIONAL INFORMATION

If more than one screen, show locations of each on sketch.