

JACKSON MISSISSIPPI BOARD OF WATER COMMISSIONERS

M 46

4-1-63

WATER WELL DRILLERS LOG

Date: April 1, 1963, Driller: George Colville County Jackson
(Name)

4 R

	Description & Color of Materials Sand, Clay, Red Clay, Shell, etc.	Thick- ness Feet	Depth Feet
(1) Owner of Land: <u>Lilly Orchard Bapt. Church</u> <small>(Name)</small>	<u>Sand</u>		<u>66</u>
<u>Helena Miss</u> <small>(Address)</small>	<u>Clay</u>	<u>114</u>	<u>280</u>
(2) Location: <u>SW 1/4, NE 1/4, Sec. 14 T. 6 R. 5 W.</u>	<u>Rock</u>	<u>6</u>	<u>286</u>
<u>1/2</u> miles <u>Northwest</u> of <u>Mass Point</u> <small>(distance) (direction) (Nearest Town)</small>	<u>clay</u>	<u>26</u>	<u>372</u>
(3) Topography: <u>Hilly</u> <small>(Hilly) (Flat) (Level)</small>	<u>Sand</u>	<u>17</u>	<u>389</u>
(4) Purpose of Well: <u>Church Supply</u> <small>(Domestic Irrigation Municipal, Industrial, Other)</small>			


Information upon completion of well:

- (1) Diameter 2 inches.
- (2) Total Depth 389 feet.
- (3) Water Level 7' feet below top of ground.
- (4) Cased to _____, Size _____.
- (5) Screen: Size 2, Length 10'.
- (6) Were any formations sealed against pollution?
 yes, no.

If YES depth of formation _____.

Why _____.

Drillers Remarks: _____

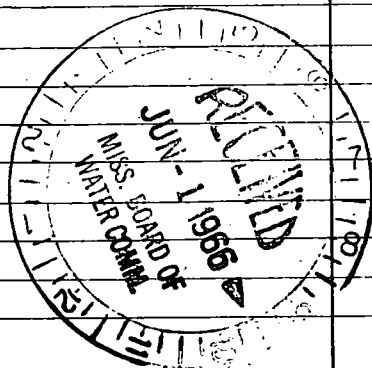

(Use Back Side)

Well No. 808

