

JACKSON MISSISSIPPI BOARD OF WATER COMMISSIONERS

M 47

5-14-63

WATER WELL DRILLERS LOG

Date: May 14, 1963, Driller: George W. Cobello County Jackson

4 R

(Name)

(1) Owner of Land: Pat Presley
(Name)
P.O. Box 282 Pascagoula, Miss.
(Address)

(2) Location: SW 1/4, NE 1/4, Sec. 36 T6 R5,
7 miles NE of Orange Grove
(distance) (direction) (Nearest Town)

(3) Topography: level
(Hilly) (Flat) (Level)

(4) Purpose of Well: Domestic
(Domestic Irrigation
 Municipal, Industrial, Other)

Description & Color of Materials Sand, Clay, Red Clay, Shell, etc.	Thick- ness Feet	Depth Feet
Clay	4	4
Sand	44	48
Clay	7	55
Sand	11	66
Clay	60	126
Sand	94	220
Clay	102	322
Sand	30	352

Information upon completion of well:

(1) Diameter 2 inches.

(2) Total Depth 352 feet.

(3) Water Level +24'-3 feet ^{above} ~~below~~ top of ground.

(4) Cased to 342, Size 2


(5) Screen: Size 3052, Length 10 ft.

(6) Were any formations sealed against pollution?
 _____ yes, no.

If YES depth of formation _____

Why _____

Drillers Remarks: _____

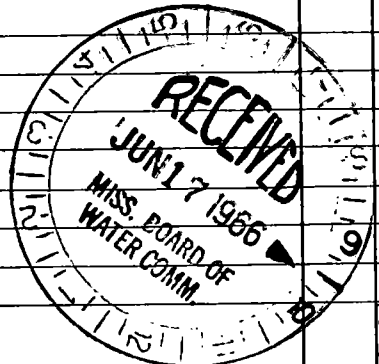

Well No. 218

(Use Back Side)

