

49

Jackson
M 48
4-63

MISSISSIPPI
 BOARD OF WATER COMMISSIONERS
 416 North State Street
 Jackson, Mississippi 39201

WATER WELL DRILLERS LOG

April 30 19 63 Calville Water Supply Co INC Jackson
 date well completed firm name county well located

LANDOWNER: W.H. Garner

description of formations encountered

from

to

Big Point Miss
(mailing address)

WELL LOCATION:

sec. 8 T. 6 N R. 5 E
 14 miles NE of Big Point
 (distance) (direction) (nearest town)

WELL PURPOSE: Home
(home, irrigation, municipal, industrial)

WELL COMPLETION DATA:

- (1) diameter (inches) 1 1/4
- (2) total depth (feet) 756
- (3) static water level (feet) 18 below top of ground
- (4) casing (material) (depth)
 (size) If telescope see back.
- (5) screen 10, 746
 (length) (depth to top)
 1 1/4, Brgos
 (size) (material)
- (6) pump Noac
 (HP) (yield gpm)
 (type power)
- (7) electric log No
 (yes or no)
 (organization running log)
- (8) how well bottom plugged

Sand	0	110
Clay	110	147
Sand	147	185
Clay	185	258
Sand	258	278
Clay	278	399
Small Clay Shells	399	404
Clay	404	498
Sand	498	572
Clay with Sand Strs	572	733
Sand	733	756


DRILLERS REMARKS:



If well telescopes please sketch and show depths.

GROUND LEVEL

SE NW

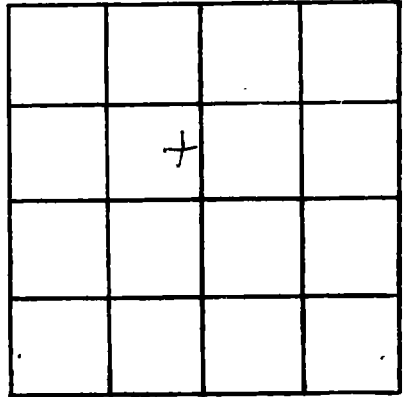

SECTION 8

Please indicate well location X.

ADDITIONAL INFORMATION

If more than one screen, show locations of each on sketch.