

49

Jackson
M 49
6-63

MISSISSIPPI  
 BOARD OF WATER COMMISSIONERS  
 416 North State Street  
 Jackson, Mississippi 39201

WATER WELL DRILLERS LOG

June 14 1963 Colville Water Supply Jackson  
 date well completed firm name county well located

LANDOWNER: Frank Vice

description of formations encountered	from	to
<u>Clay</u>	<u>0</u>	<u>15</u>
<u>Sand</u>	<u>15</u>	<u>78</u>
<u>Oil</u>	<u>78</u>	<u>126</u>
<u>Shale</u>	<u>126</u>	<u>157</u>

Helena, Miss  
(mailing address)

WELL LOCATION:

sec. 32 6 N 5 R 5 E  
8 miles NE of Marion  
 (distance) (direction) (nearest town)

WELL PURPOSE: Home  
(home, irrigation, municipal, industrial)

WELL COMPLETION DATA:

- (1) diameter (inches) 1 1/4
- (2) total depth (feet) 157
- (3) static water level (feet) 11'4" <sup>below</sup>/<sub>above</sub> top of ground.
- (4) casing \_\_\_\_\_ (material), \_\_\_\_\_ (depth), \_\_\_\_\_ (size) if telescope see back.
- (5) screen 5, 147 (length), (depth to top)  
1 1/4, brass (size), (material)
- (6) pump \_\_\_\_\_ (HP), \_\_\_\_\_ (yield gpm)  
(type power)
- (7) electric log no (yes or no)  
(organization running log)
- (8) how well bottom plugged CP lake




DRILLERS REMARKS:

If well telescopes please sketch and show depths.

GROUND LEVEL

Nw Sw

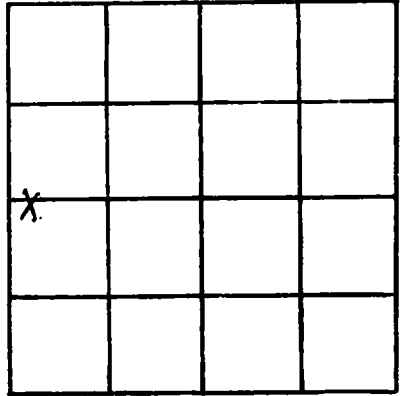

SECTION 32

Please indicate well location X.

ADDITIONAL INFORMATION

If more than one screen, show locations of each on sketch.