

49

MISSISSIPPI
 BOARD OF WATER COMMISSIONERS
 416 North State Street
 Jackson, Mississippi 39201

WATER WELL DRILLERS LOG

Jackson
 M 50
 6-63

June 20 1963 Coburns Water Supply Jackson
 date well completed firm name county well located

LANDOWNER:

Willard

description of formations encountered

from

to

Helena Min
 (mailing address)

Clay

0 30

Sand

30 55

Clay

55 173

Sand

173 207

WELL LOCATION:

sec. 32 T. 6 N. R. 5 E

90 miles NE of Moore Point
 (distance) (direction) (nearest town)

WELL PURPOSE:

home (home, irrigation, municipal, industrial)

WELL COMPLETION DATA:

- (1) diameter (inches) 1 1/4
- (2) total depth (feet) 202
- (3) static water level (feet) 17' 9" ^{below} above top of ground.

(4) casing (material) (depth)

(size) if telescope see back.

(5) screen 10' 192
 (length) (depth to top)

1 1/4 Brass
 (size) (material)

(6) pump (HP) (yield gpm)


(type power)

(7) electric log no
 (yes or no)

(organization running log)

(8) how well bottom plugged BP. Well


DRILLERS REMARKS:

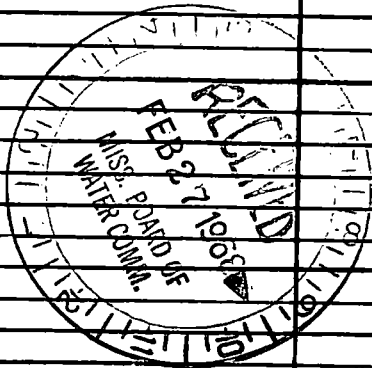

If well telescopes please sketch and show depths.

GROUND LEVEL

SW NW

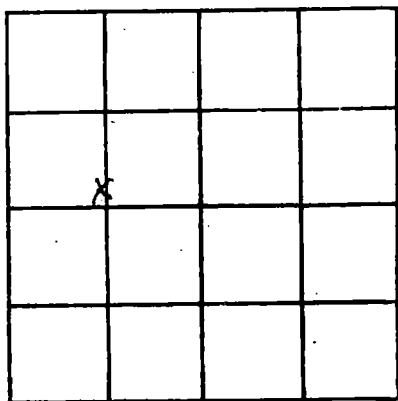

SECTION 32

Please indicate well location X.

ADDITIONAL INFORMATION

If more than one screen, show locations of each on sketch.