

4 Q

Jackson
M 51
7-63

MISSISSIPPI
 BOARD OF WATER COMMISSIONERS
 416 North State Street
 Jackson, Mississippi 39201

WATER WELL DRILLERS LOG

July 6 19 63 Colville Water Supply Jackson
 date well completed firm name county well located

LANDOWNER: Leon Bowen

description of formations encountered	from	to
	clay	0
sand	21	189
clay	189	231
sand	231	249

Scottsboro, Miss
(mailing address)

WELL LOCATION:

sec. 32 T 6 N R 5 E
 (S) (W)
6 miles NE of MP
 (distance) (direction) (nearest town)

WELL PURPOSE: home
(home, irrigation, municipal, industrial)

WELL COMPLETION DATA:

- (1) diameter (inches) 1 1/4
- (2) total depth (feet) 249
- (3) static water level (feet) 5' 8" ^{below} above top of ground.
- (4) casing _____ (material), _____ (depth), _____ (size) If telescope see back.
- (5) screen 5' 244 (length) (depth to top)
1 1/4 brass (size) (material)
- (6) pump _____ (HP) _____ (yield gpm)
_____ (type power)
- (7) electric log no (yes or no)
_____ (organization running log)
- (8) how well bottom plugged BP Valve


DRILLERS REMARKS:



If well telescopes please sketch and show depths.

GROUND LEVEL

NE NE

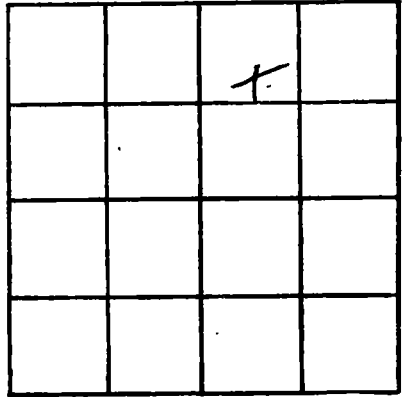

SECTION 32

Please indicate well location X.

ADDITIONAL INFORMATION

If more than one screen, show locations of each on sketch.