

Jackson
M52
10-63

MISSISSIPPI
BOARD OF WATER COMMISSIONERS
416 North State Street
Jackson, Mississippi 39201

WATER WELL DRILLERS LOG

Oct 2 1963 Colville Water Supply Jackson
date well completed firm name county well located

LANDOWNER Samie Porter

description of formations encountered from to

Helena Miss
(mailing address)

Sand 0 74
Clay 74 126
Sand 126 152

WELL LOCATION:


sec. 31 T 6 N R 5 E
4 miles NE of Moss Bluff
(distance) (direction) (nearest town)

WELL PURPOSE:

(home, irrigation, municipal, industrial)

WELL COMPLETION DATA:

- (1) diameter (inches) 2"
- (2) total depth (feet) 152
- (3) static water level (feet) 10 ^{below}/_{above} top of ground.
- (4) casing _____ (material), _____ (depth), _____ (size) if telescope see back.
- (5) screen 10 _____, 142 _____
(length) (depth to top)
2 _____, Stainless _____
(size) (material)
- (6) pump _____ (HP) _____ (yield gpm)
_____ (type power)
- (7) electric log no _____
(yes or no)
_____ (organization running log)
- (8) how well bottom plugged BP Value

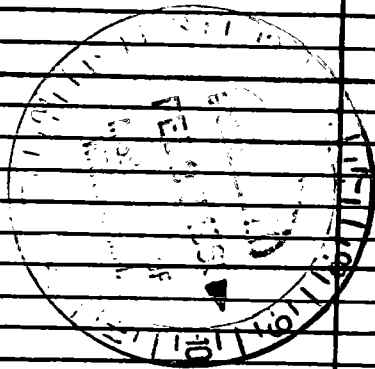


DRILLERS REMARKS:

If well telescopes please sketch and show depths.

GROUND LEVEL

NW SE

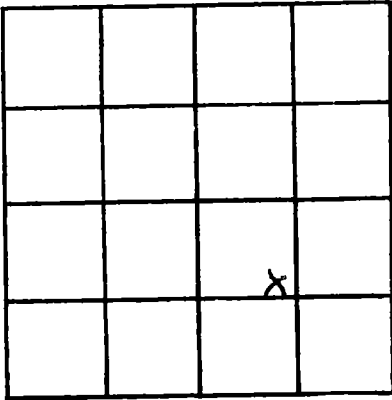

SECTION 31

Please indicate well location X.

ADDITIONAL INFORMATION

If more than one screen, show locations of each on sketch.