

49

Jackson  
M 53  
11-63

MISSISSIPPI  
BOARD OF WATER COMMISSIONERS  
416 North State Street  
Jackson, Mississippi 39201

WATER WELL DRILLERS LOG

Nov 11 1963 date well completed  
White Water Supply firm name  
Jackson county well located


LANDOWNER: Raymond  
Taylor  
Helena Miss  
(mailing address)

description of formations encountered	from	to
Clay	0	18
Sand	18	96
Clay	96	147
Sand	147	159

WELL LOCATION:  
sec. 32 T. 6 N. R. 5 E  
1 1/2 miles NE. of Escatawpa  
(distance) (direction) (nearest town)

WELL PURPOSE: Annual  
(home, irrigation, municipal, industrial)

- WELL COMPLETION DATA:
- (1) diameter (inches) 1 1/4
  - (2) total depth (feet) 154
  - (3) static water level (feet) 10 <sup>below</sup> <sub>above</sub> top of ground.
  - (4) casing (material) (depth)  
(size) If telescope see back.
  - (5) screen 5' 154  
(length) (depth to top)  
1/4" brass  
(size) (material)
  - (6) pump (HP) (yield gpm)  
(type power)
  - (7) electric log no  
(yes or no)  
(organization running log)
  - (8) how well bottom plugged BR

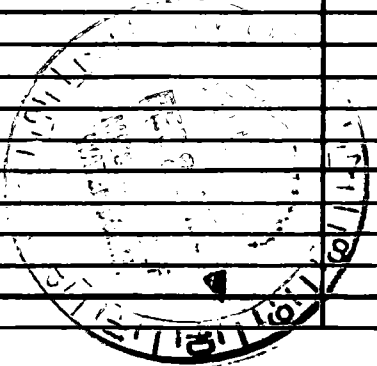


DRILLERS REMARKS:

If well telescopes please sketch and show depths.

GROUND LEVEL

SW NE

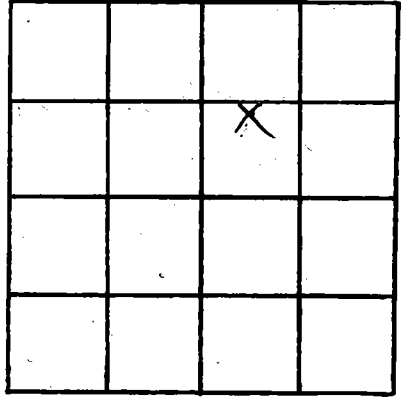

SECTION 32

Please indicate well location X.

ADDITIONAL INFORMATION

If more than one screen, show locations of each on sketch.