

40

Jackson
M 54
11-63

MISSISSIPPI
 BOARD OF WATER COMMISSIONERS
 416 North State Street
 Jackson, Mississippi 39201

WATER WELL DRILLERS LOG

Nov 7 1963 Colville Water Supply Jackson
 date well completed firm name county well located

LANDOWNER: Mrs. Morris Young
Franklin Creek Miss.
 (mailing address)


description of formations encountered	from	to
Sand	0	71

WELL LOCATION:
 sec. 31 T. 6 N. R. 4 E.
6 miles West of Meridian
 (distance) (direction) (nearest town)

WELL PURPOSE: Home
 (home, irrigation, municipal, industrial)

WELL COMPLETION DATA:

- (1) diameter (inches) 1 1/4
- (2) total depth (feet) 71
- (3) static water level (feet) 10 ^{below}/_{above} top of ground.
- (4) casing _____ (material), _____ (depth), _____ (size) If telescope see back.
- (5) screen 5' 66 (length) (depth to top)
1 1/4 brass (size) (material)
- (6) pump _____ (HP) _____ (yield gpm)
 _____ (type power)
- (7) electric log yes (yes or no)
 _____ (organization running log)
- (8) how well bottom plugged BP Valley

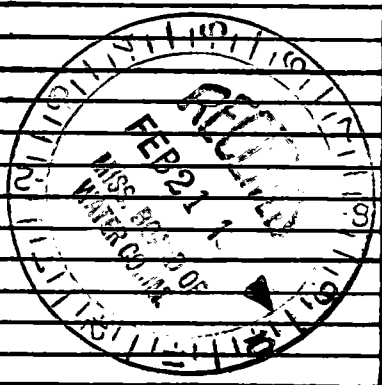

DRILLERS REMARKS: _____

If well telescopes please sketch and show depths.

SE/NE

GROUND LEVEL

SECTION 31

Please indicate well location X.

ADDITIONAL INFORMATION

If more than one screen, show locations of each on sketch.