

4 R

Jackson
M 55
12-63

MISSISSIPPI
BOARD OF WATER COMMISSIONERS
416 North State Street
Jackson, Mississippi 39201

WATER WELL DRILLERS LOG

Dec 3 19 63 Calvert Water Supply Jackson
date well completed firm name county well located

LANDOWNER: Ray Presley

description of formations encountered	from	to
<u>Sand</u>	<u>0</u>	<u>70</u>
<u>Clay</u>	<u>70</u>	<u>223</u>
<u>Sand</u>	<u>223</u>	<u>348</u>

Good Lake Min
(mailing address)


WELL LOCATION:
sec. 36 T 6 N R 5 E
10 miles East of Missport
(distance) (direction) (nearest town)

WELL PURPOSE: home
(home, irrigation, municipal, industrial)

WELL COMPLETION DATA:

- (1) diameter (inches) 2
- (2) total depth (feet) 348
- (3) static water level (feet) 22 below above top of ground.
- (4) casing _____ (material), _____ (depth), _____ (size) if telescope see back.
- (5) screen 10 _____ 338 _____ (length) (depth to top) 2 _____ (size) Bron (material)
- (6) pump _____ (HP) _____ (yield gpm) _____ (type power)
- (7) electric log no _____ (yes or no) _____ (organization running log)
- (8) how well bottom plugged B.P. Palox


DRILLERS REMARKS:

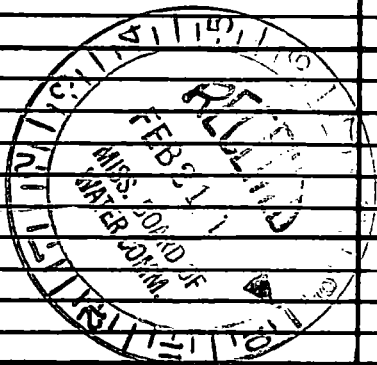

If well telescopes please sketch and show depths.

GROUND LEVEL

SW NE

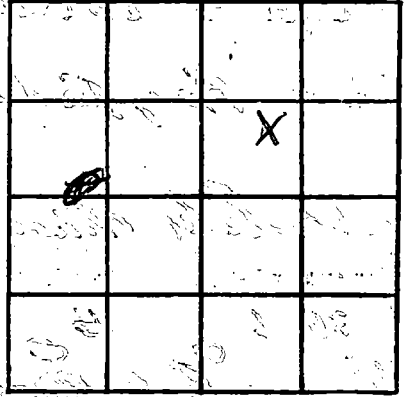

SECTION 36

Please indicate well location X.

ADDITIONAL INFORMATION

If more than one screen, show locations of each on sketch.