

4 R

Jackson
M 56
12-63

MISSISSIPPI
BOARD OF WATER COMMISSIONERS
416 North State Street
Jackson, Mississippi 39201

WATER WELL DRILLERS LOG

Dec 10 1963 Orville Water Supply Jackson
date well completed firm name county well located

LANDOWNER: Bon Beckley

| description of formations encountered | from to | |
|---------------------------------------|---------|------|
| | feet | feet |
| clay | 0 | 21 |
| red clay | 21 | 68 |
| clay | 68 | 179 |
| sand | 179 | 199 |


Hedena, Miss
(mailing address)

WELL LOCATION:
sec. 35 T. 6 N. R. 5 E.
8 miles east of Meridian
(distance) (direction) (nearest town)

WELL PURPOSE: home
(home, irrigation, municipal, industrial)

WELL COMPLETION DATA:

- (1) diameter (inches) 1 1/4
- (2) total depth (feet) 199
- (3) static water level (feet) 6 ^{below} _{above} top of ground.
- (4) casing _____ (material), _____ (depth), _____ (size) If telescope see back.
- (5) screen 5 _____ (length), 194 _____ (depth to top), 1 1/4 _____ (size), plastic _____ (material)
- (6) pump _____ (HP), _____ (yield gpm), _____ (type power)
- (7) electric log no (yes or no), _____ (organization running log)
- (8) how well bottom plugged BPhlor

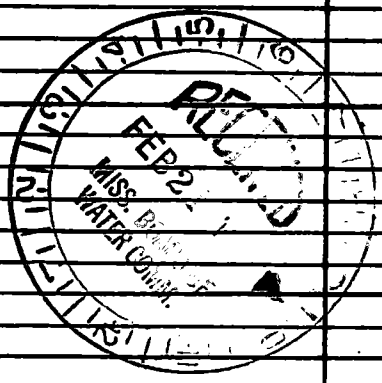


DRILLERS REMARKS:

If well telescopes please sketch and show depths.

GROUND LEVEL

NW-SE

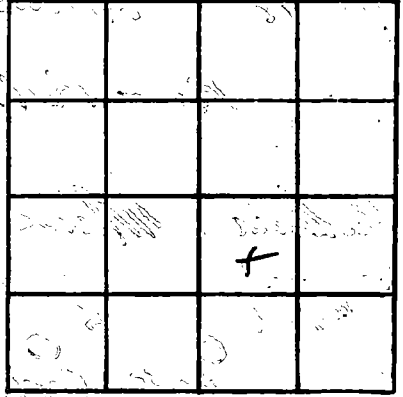

SECTION 35

Please indicate well location X.

ADDITIONAL INFORMATION

If more than one screen, show locations of each on sketch.