

49

MISSISSIPPI
 BOARD OF WATER COMMISSIONERS
 416 North State Street
 Jackson, Mississippi 39201

WATER WELL DRILLERS LOG

Jackson
 M 57
 3-64

March 31 1964 date well completed
 Cabell Water Supply firm name
 Jackson county well located

LANDOWNER: Pat Patterson

description of formations encountered	depth	
	from	to
clay	0	12
sand	12	60
clay	60	131
sand	131	147

Holena Miss
 (mailing address)


WELL LOCATION:
 sec 32 T 6 N R 5 E
6 miles NE of Meridian
 (distance) (direction) (nearest town)

WELL PURPOSE: home
 (home, irrigation, municipal, industrial)

WELL COMPLETION DATA:

- (1) diameter (inches) 1 1/4
- (2) total depth (feet) 147
- (3) static water level (feet) 10' ^{below} above top of ground
- (4) casing _____ (material) _____ (depth) _____
 _____ if telescope see back.
 (size)
- (5) screen 10 _____ 137
 (length) (depth to top)
1 1/4 _____ plastic
 (size) (material)
- (6) pump _____ (HP) _____ (yield gpm)
 _____ (type power)
- (7) electric log no (yes or no)
 _____ (organization running log)
- (8) how well bottom plugged BP Jones


DRILLERS REMARKS:

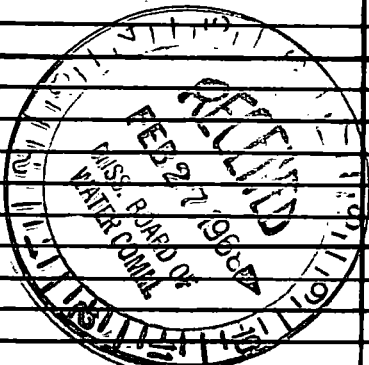

If well telescopes please sketch and show depths.

NW/NE

GROUND LEVEL

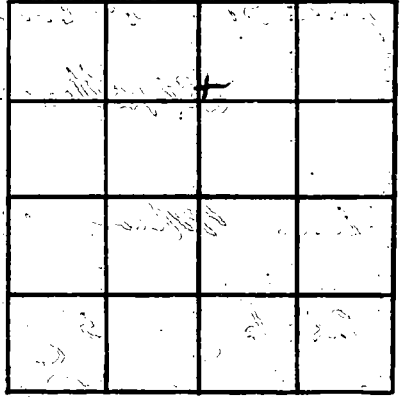

SECTION 32

Please indicate well location X.

ADDITIONAL INFORMATION

Multiple horizontal lines for additional information.

If more than one screen, show locations of each on sketch.