

M59
4-6-65

WATER WELL DRILLERS LOG

Date: Apr 6, 1965, Driller: George Colville County Jackson
4 8 (Name)

(1) Owner of Land: Bert Fisher
(Name)
Helena Miss
(Address)

(2) Location: NE 1/4, SW 1/4, Sec. 28 T6S R5W
3 miles NE, of Mossburn
(distance) (direction) (Nearest Town)

(3) Topography: flat
(Hilly) (Flat) (Level)

(4) Purpose of Well: dom
(Domestic Irrigation
Municipal, Industrial, Other)

Description & Color of Materials Sand, Clay, Red Clay, Shell, etc.	Thick- ness Feet	Depth Feet
Clay	16	16
sand	2	18
Clay	4	22
Clay w/ sand strips	44	66
Clay	44	110
Clay w/ sand strips	44	154
Clay	76	220
sand	15	235
Clay	51	286
sand	8	294

Information upon completion of well:

(1) Diameter 1 1/4 inches.

(2) Total Depth 294 feet.

(3) Water Level 4' 10" feet below top of ground.

(4) Cased to 199, Size 1 1/4


(5) Screen: Size .008, Length 5 ft

(6) Were any formations sealed against pollution?
_____ yes, X no.

If YES depth of formation _____

Why _____

Drillers Remarks: _____

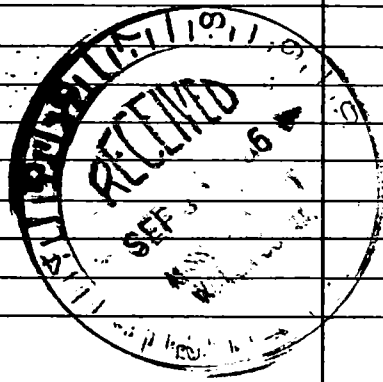

(Use Back Side)

Well No.

