

Jackson

M60

MISSISSIPPI BOARD OF WATER COMMISSIONERS

3-29-66

WATER WELL DRILLERS LOG

Date: Mar 29, 1966, Driller: George Colville County Jackson

HR

(Name)

(1) Owner of Land: CHESTER LONG
(Name)

ORANGE GROVE, Miss.
(Address)

(2) Location: NE 1/4, SW 1/4, Sec 32 T6SR4W
8 miles EAST of Kreole
(distance) (direction) (Nearest Town)

(3) Topography: LEVEL
(Hilly) (Flat) (Level)

(4) Purpose of Well: DOM
(Domestic Irrigation
Municipal, Industrial, Other)

Description & Color of Materials Sand, Clay, Red Clay, Shell, etc.	Thick- ness Feet	Depth Feet
CLAY	10	10
SAND	12	22
GRAVEL	20	42
CLAY	6	48
SAND	14	62
CLAY	4	66
CLAY & SAND STRKS	29	95
CLAY	30	125
SAND	24	149
CLAY	5	154
ROCK	1	155
SAND	5	160
CLAY	95	255
SAND	4	259
CLAY	49	308
SAND	115	423

Information upon completion of well:

(1) Diameter 2 inches.

(2) Total Depth 423 feet.

(3) Water Level 422 feet below top of ground.

(4) Cased to 418, Size 2 in

(5) Screen: Size 2 in 10/10, Length 5


(6) Were any formations sealed against pollution?

yes, no.

If YES depth of formation _____

Why _____

Drillers Remarks: _____

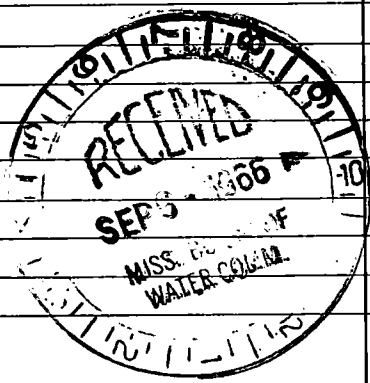

(Use Back Side)

Well No.

Handwritten text at the top of the page, possibly a header or title, including the number '100' on the right side.

Handwritten text, possibly a name or title, located in the upper right quadrant.

Handwritten text, possibly a name or title, located in the upper right quadrant.

Vertical column of handwritten text on the left side of the page, possibly a list or index.

Horizontal line of handwritten text across the middle of the page.

Handwritten text, possibly a name or title, located in the middle right area.

Handwritten text, possibly a name or title, located in the middle right area.

Small handwritten mark or symbol.

Handwritten text, possibly a name or title, located in the lower right area.