

4-23-66 WATER WELL DRILLERS LOG

Date: APR 23 1966, Driller: George Colville County Jackson
 4 R (Name)

(1) Owner of Land: T. E. PATTERSON
 (Name)
ORANGE GROVE, Miss.
 (Address)

(2) Location: NE 1/4, SW 1/4, Sec 32 T15 R44
8 miles E of Kreole
 (distance) (direction) (Nearest Town)

(3) Topography: Level
 (Hilly) (Flat) (Level)

(4) Purpose of Well: Dom
 (Domestic Irrigation
 Municipal, Industrial, Other)

Description & Color of Materials Sand, Clay, Red Clay, Shell, etc.	Thick- ness Feet	Depth Feet
SAND	22	22
Blue Clay	9	31
Wood	2	33
SAND	32	65
CLAY	25	90
SAND	10	100
CLAY	10	110
SAND	12	122
CLAY	6	128
SAND	22	150
CLAY	92	242
SAND	22	264
CLAY	66	330
SAND	103	433

Information upon completion of well:

(1) Diameter 2 inches.

(2) Total Depth 433 feet.

(3) Water Level 722 feet above top of ground.

(4) Cased to 428, Size 2 in


(5) Screen: Size 2-.100, Length 5 in.

(6) Were any formations sealed against pollution?
 _____ yes, no.

If YES depth of formation _____

Why _____

Drillers Remarks: _____

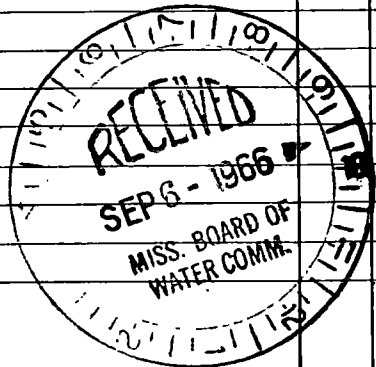

Handwritten text, possibly bleed-through from the reverse side of the page. The text is extremely faint and illegible due to the quality of the scan. Some faint words like "The" and "of" are visible.