

Jackson
M 63
7-9-66

MISSISSIPPI BOARD OF WATER COMMISSIONERS

WATER WELL DRILLERS LOG

Date: July 9, 1966, Driller: J.P. STARK (Colville) County Jackson
49 (Name)

(1) Owner of Land: J.P. Denny
(Name)
Helena, Miss.
(Address)

(2) Location: NW 1/4, NW 1/4, Sec. 28, T6S, R5W
_____ miles _____ in _____ of Helena,
(distance) (direction) (Nearest Town)

(3) Topography: FLAT
(Hilly) (Flat) (Level)

(4) Purpose of Well: Dom
(Domestic Irrigation
Municipal, Industrial, Other)

Description & Color of Materials Sand, Clay, Red Clay, Shell, etc.	Thick- ness Feet	Depth Feet
CLAY	22	22
SAND	18	40
CLAY	4	44
SAND	32	76
CLAY	8	88
SAND	22	110
CLAY	22	132
SAND	83	215
CLAY	5	220
SAND	42	262

Information upon completion of well:

(1) Diameter 1 1/4 inches.

(2) Total Depth 262 feet.

(3) Water Level 1 feet below top of ground.


(4) Cased to 254, Size 1 1/4

(5) Screen: Size 1/4 8000, Length 8 ft

(6) Were any formations sealed against pollution?
_____ yes, no.

If YES depth of formation _____
Why _____

Drillers Remarks: _____

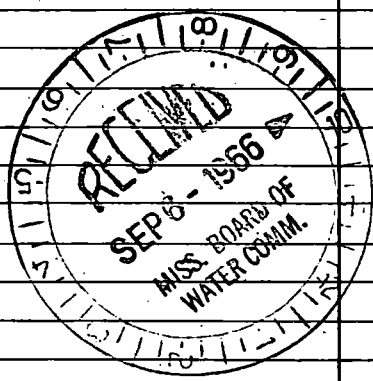

(Use Back Side)

Well No.

