

M 65

8-66

WATER WELL DRILLERS LOG

Date: Aug 5, 1966, Driller: J. C. STORCK (Colville) County Jackson
 49 (Name)


(1) Owner of Land: FRANK M. Shields
 (Name)
Hwy 613 Helena, Miss
 (Address)
 (2) Location: NE 1/4, NE 1/4, Sec. 8 T8S R5W
12 miles NE of MOSS POINT
 (distance) (direction) (Nearest Town)
 (3) Topography: FLAT
 (Hilly) (Flat) (Level)
 (4) Purpose of Well: Dom
 (Domestic Irrigation, Municipal, Industrial, Other)

Description & Color of Materials Sand, Clay, Red Clay, Shell, etc.	Thick- ness Feet	Depth Feet
CLAY	12	12
SAND	6	18
SAND & CLAY STRKS	26	44
SAND	66	110
CLAY	44	154
SAND	28	182
CLAY	6	188
SAND	30	218
CLAY	42	260
SAND	48	308
CLAY	77	385
SAND	11	396
CLAY	134	530
SAND	12	542
CLAY	6	548
SAND (shells)	46	594
CLAY	132	726
FINE SAND	18	744
CLAY	92	836
FINE SAND	22	858
SAND	22	880
CLAY (shells)	44	924
CLAY-SAND STRKS	44	968
CLAY	90	1058
SAND	30	1088

Information upon completion of well:

(1) Diameter 2 inches.
 (2) Total Depth 1088 feet.
 (3) Water Level 441.5 feet ABOVE ~~below~~ top of ground.
 (4) Cased to 1077, Size 2 in.
 (5) Screen: Size .012, Length 10 ft.
 (6) Were any formations sealed against pollution?
 _____ yes, no.

If YES depth of formation _____
 Why _____
 Drillers Remarks: _____

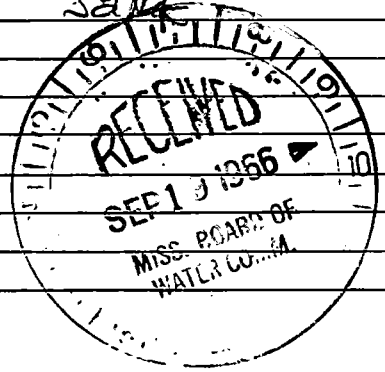

(Use Back Side)

Well No.

1948-1949

1950-1951

1952-1953