

M 66

WATER WELL DRILLERS LOG

8-66

Date: Aug 17, 1966, Driller: J.C. STARK (Colville) County Jackson

4 R

(Name)

(1) Owner of Land: JIMMY WRIGHT
 (Name)
ESCHTOWPE, MISS.
 (Address)

(2) Location: NE 1/4, NE 1/4, Sec. 25 T6SR5W
6 1/2 miles N of MOSS POINT
 (distance) (direction) (Nearest Town)

(3) Topography: FLAT
 (Hilly) (Flat) (Level)

(4) Purpose of Well: Dam
 (Domestic Irrigation
 Municipal, Industrial, Other)

Description & Color of Materials Sand, Clay, Red Clay, Shell, etc.	Thick- ness Feet	Depth Feet
Clay	15	15
sand	117	132
sand w/clay STRKS	44	176
Clay	18	194
sand	4	198
CLAY	220	418
CLAY w/sand STRKS	12	430
FINE sand	20	450
sand		460

Information upon completion of well:

(1) Diameter 1 1/4 inches.

(2) Total Depth 460 feet.

(3) Water Level 0 feet below top of ground.

(4) Cased to 450, Size 1 1/4


(5) Screen: Size 80 ga., Length 10 ft.

(6) Were any formations sealed against pollution?
 _____ yes, no.

If YES depth of formation _____

Why _____

Drillers Remarks: _____

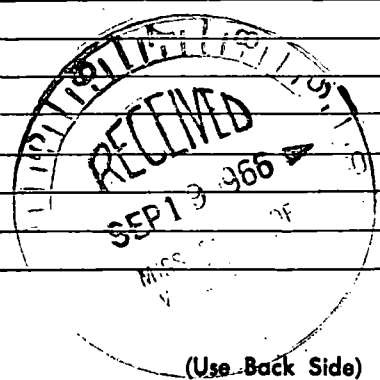

(Use Back Side)

Well No.

