

49
 Jackson
 M 69
 1-68

MISSISSIPPI
 BOARD OF WATER COMMISSIONERS
 416 North State Street
 Jackson, Mississippi 39201

WATER WELL DRILLERS LOG
~~COAST WATER WELL SERVICE~~

JACKSON

1-22-68 date well completed 19 ~~68~~ firm name county well located

LANDOWNER: John Christiane
Rural Route
Pascagoula Miss
 (mailing address)

description of formations encountered	from	to
RED CLAY	0	15
COARSE SAND & GRAVEL	15	101
G. Blue Clay	101	170
FINE SAND	170	176
G. Blue Clay	176	200
MED. SAND	200	220

WELL LOCATION:
 sec. 7 T 6 N R 5 E
 S W
8 miles North of Pass Point
 (distance) (direction) (nearest town)

WELL PURPOSE: Home
 (home, irrigation, municipal, industrial)

WELL COMPLETION DATA:

(1) diameter (inches) 2"

(2) total depth (feet) 220'

(3) static water level (feet) 16' below above top of ground.

(4) casing GALV., 210'
 (material) (depth)
2"
 (size) if telescope see back.

(5) screen 10', 210'
 (length) (depth to top)
2" Plastic
 (size) (material)


(6) pump 1 10
 (HP) (yield gpm)
Elect
 (type power)

(7) electric log NO
 (yes or no)

(organization running log)

(8) how well bottom plugged 2" BACK
WASH VALVE


DRILLERS REMARKS:

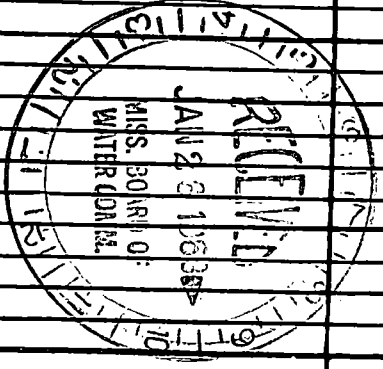

If well telescopes please sketch and show depths.

GROUND LEVEL

SE NW

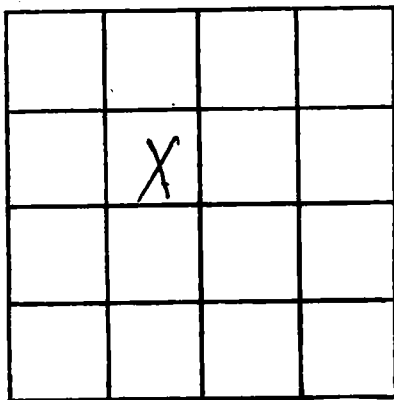

SECTION 7

Please indicate well location X.

ADDITIONAL INFORMATION

If more than one screen,
show locations of each on sketch.