

JACKSON MISSISSIPPI BOARD OF WATER COMMISSIONERS

M 71
2-15-61

WATER WELL DRILLERS LOG
COLVILLE

M 300

Date: 2/15, 1961, Driller: Water Supply Co. County JACKSON
(Name)
4R

(1) Owner of Land: B Alexander
(Name)
Orange Grove Miss
(Address)

(2) Location: SE 1/4 SE 1/4, Sec 31 T17R4W
5 miles East, of Pascagoula
(distance) (direction) (Nearest Town)

(3) Topography: (Hilly) (Flat) (level)

(4) Purpose of Well: Domestic Irrigation
Municipal, Industrial, Other

Description & Color of Materials Sand, Clay, Red Clay, Shell, etc.		Thick- ness Feet	Depth Feet
0	SAND	30	Clay
42	CLAY	64	Sand
74			
	JD		

Information upon completion of well:

(1) Diameter 1 1/4 inches.

(2) Total Depth 74 feet.

(3) Water Level 12 feet below top of ground.

(4) Cased to _____, Size _____

(5) Screen: Size 1 1/4, Length 5'


(6) Were any formations sealed against pollution?
_____ yes, _____ no.

If YES depth of formation _____

Why _____

Drillers Remarks: _____

Water level 12'

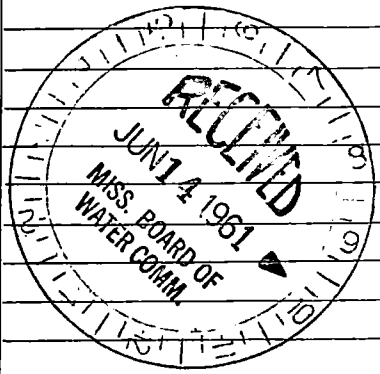

(Use Back Side)

Well No. 31

