

JACKSON
M75
6-64

MISSISSIPPI
BOARD OF WATER COMMISSIONERS
416 North State Street
Jackson, Mississippi 39201

WATER WELL DRILLERS LOG

June 26 1964 Colville Water Supply Jackson
date well completed firm name county well located

LANDOWNER: Oliver Vire Jr.

description of formations encountered	from	to
clay	0	10
sand	10	70
clay	70	147
sand	147	177

Helena, Miss.
(mailing address)

WELL LOCATION:
sec 32 T 6 N R 5 E
1 miles NE of Helena
(distance) (direction) (nearest town)

WELL PURPOSE: home
(home, irrigation, municipal, industrial)


- WELL COMPLETION DATA:
- (1) diameter (inches) 1 1/4
 - (2) total depth (feet) 177
 - (3) static water level (feet) 10 ^{below}/_{above} top of ground.
 - (4) casing galv, 172
(material) (depth)
(size) If telescope see back.
 - (5) screen 5, 172
(length) (depth to top)
1/4, stainless
(size) (material)
 - (6) pump _____ (HP) _____ (yield gpm)
(type power)
 - (7) electric log no
(yes or no)
(organization running log)
 - (8) how well bottom plugged BP/cho

MAY 27 1968
MISS. BOARD OF
WATER

DRILLERS REMARKS: pump installed by owner

If well telescopes please sketch and show depths.

GROUND LEVEL

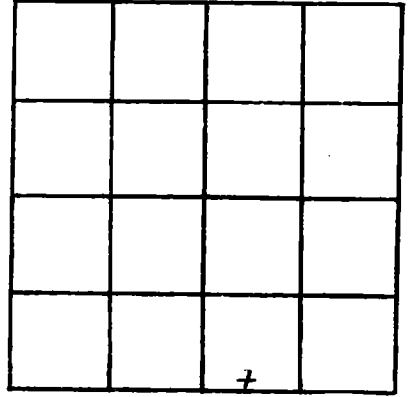

SECTION 32

Please indicate well location X.

ADDITIONAL INFORMATION

If more than one screen,
show locations of each on sketch.