

JACKSON
M 76
6-64

MISSISSIPPI
BOARD OF WATER COMMISSIONERS
416 North State Street
Jackson, Mississippi 39201

WATER WELL DRILLERS LOG

June 24 1964 Cabild Water Supply Jackson
date well completed firm name county well located


LANDOWNER: Mason and Parker	description of formations encountered	from	to
Helen Miss (mailing address)	Clay	0	10
WELL LOCATION:	sand	10	62
sec. 29 T 6 N R 5 E 1 1/2 miles NE of (distance) (direction) (nearest town)	clay	62	175
WELL PURPOSE: home (2) (home, irrigation, municipal, industrial)	sand	175	200
WELL COMPLETION DATA:	clay	200	205
(1) diameter (inches) 1 1/4	sand	205	217
(2) total depth (feet) 217			
(3) static water level (feet) 6 below top of ground.			
(4) casing galv 212 (material) (depth)			
If telescope see back. (size)			
(5) screen 5 212 (length) (depth to top)			
1 1/4 stainless (size) (material)			
(6) pump (HP) (yield gpm)			
(type power)			
(7) electric log no (yes or no)			
(organization running log)			
(8) how well bottom plugged B.P. valve			
DRILLERS REMARKS: Pumps installed by owner			

MAY 27 1968

MISS. BOARD OF
WATER COMM.

If well telescopes please sketch and show depths.

GROUND LEVEL

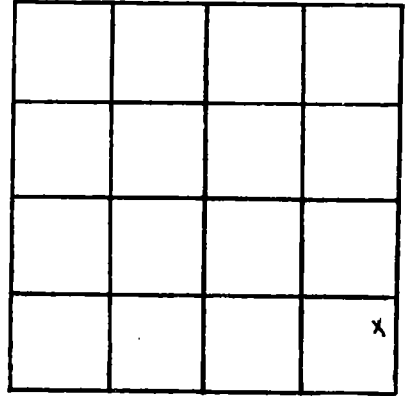

SECTION 29

Please indicate well location X.

ADDITIONAL INFORMATION

If more than one screen, show locations of each on sketch.