

JACKSON  
M 77  
9-64

MISSISSIPPI  
BOARD OF WATER COMMISSIONERS  
416 North State Street  
Jackson, Mississippi 39201

WATER WELL DRILLERS LOG

Sept 24 1964 date well completed  
Coburn Water Supply firm name  
Jackson county well located

LANDOWNER: Claude Vice  
Helena Miss  
(mailing address)

WELL LOCATION:  
sec. 29 T. 6 N. R. 5 E  
6 miles NE of Macon  
(distance) (direction) (nearest town)

WELL PURPOSE: home  
(home, irrigation, municipal, industrial)

WELL COMPLETION DATA:  
(1) diameter (inches) 1 1/4  
(2) total depth (feet) 264  
(3) static water level (feet) 12 <sup>below</sup> above top of ground.  
(4) casing galv. 261  
(material) (depth)  
If telescope see back.  
(size)  
(5) screen 1 1/4 261  
(length) (depth to top)  
1 1/4 stainless  
(size) (material)  
(6) pump \_\_\_\_\_  
(HP) (yield gpm)  
(type power)  
(7) electric log no  
(yes or no)  
(organization running log)  
(8) how well bottom plugged BPI log

description of formations encountered	from	to
clay	0	10
sand	20	40
clay	40	154
sand	154	215
clay	215	246
sand	246	264


MAY 27 1968

MISS. BOARD OF  
WATER COMMISSIONERS

DRILLERS REMARKS: Pump installed by owner

If well telescopes please sketch and show depths.

GROUND LEVEL

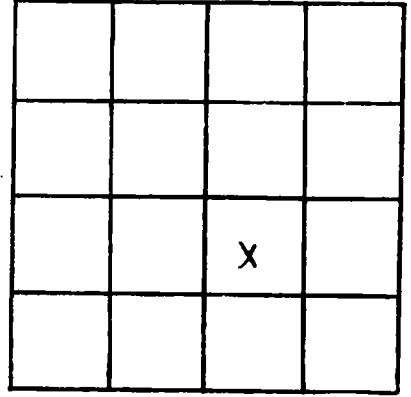

SECTION 29

Please indicate well location X.

ADDITIONAL INFORMATION

If more than one screen,  
show locations of each on sketch.