

JACKSON  
M 78  
10-64

MISSISSIPPI  
BOARD OF WATER COMMISSIONERS  
416 North State Street  
Jackson, Mississippi 39201

WATER WELL DRILLERS LOG

Oct 16 1964 Carroll Water Supply Jackson  
date well completed firm name county well located

LANDOWNER: E. E. Eakin

description of formations encountered from to

Helena Mine  
(mailing address)

clay	0	10
sand	10	80
clay	80	210
sand	210	230

WELL LOCATION:  
sec. 31 T. 7 N. R. 5 E  
5 miles NE of Escatawamp  
(distance) (direction) (nearest town)

WELL PURPOSE: Home  
(home, irrigation, municipal, industrial)

WELL COMPLETION DATA:


- (1) diameter (inches) 1 1/4
- (2) total depth (feet) 230
- (3) static water level (feet) 8 <sup>below</sup> ~~above~~ top of ground.
- (4) casing galv  
(material) (depth)
- (size) If telescope see back.
- (5) screen 5 225  
(length) (depth to top)
- (size) (material)
- (6) pump \_\_\_\_\_  
(HP) (yield gpm)
- (type power)
- (7) electric log no  
(yes or no)
- (organization running log)
- (8) how well bottom plugged B.P. Blake

DRILLERS REMARKS: pump installed by owner

MAY 27 1968  
MISS. BOARD OF  
WATER COMM.

If well telescopes please sketch and show depths.

GROUND LEVEL

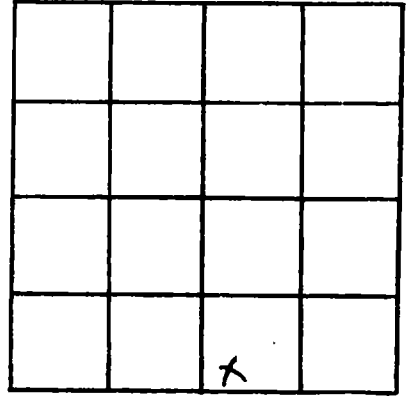

SECTION 31

Please indicate well location X.

ADDITIONAL INFORMATION

If more than one screen,  
show locations of each on sketch.