

Jackson  
M 83  
7-17-68

MISSISSIPPI  
 BOARD OF WATER COMMISSIONERS  
 416 North State Street  
 Jackson, Mississippi 39201

CODED

WATER WELL DRILLERS LOG

7-17 1968 Coast Water Well Serv. Jackson  
 date well completed firm name county well located

LANDOWNER: Powers L. May  
Route #3 Box 340 B.  
Oscageola, Miss.  
 (mailing address)

description of formations encountered	from	to
<u>Red Clay</u>	<u>0</u>	<u>12</u>
<u>Sand used to base</u>	<u>12</u>	<u>73</u>
<u>Blue Clay shale</u>	<u>73</u>	<u>241</u>
<u>Sand sub-base</u>	<u>241</u>	<u>270</u>

WELL LOCATION:  
 sec. 29 T 6 N R 5 W  
6 miles NE of Escatawpa  
 (distance) (direction) (nearest town)

WELL PURPOSE: Home  
 (home, irrigation, municipal, industrial)

WELL COMPLETION DATA:

(1) diameter (inches) 2"

(2) total depth (feet) 270'

(3) static water level (feet) 8 below above top of ground.

(4) casing galv. 265'  
 (material) (depth)  
2" If telescope see back.  
 (size)

(5) screen 5' 265'  
 (length) (depth to top)  
2" All Stainless  
 (size) (material)

(6) pump 1/2 10  
 (HP) (yield gpm)  
elec.  
 (type power)

(7) electric log NO  
 (yes or no)

(organization running log)

(8) how well bottom plugged Back  
Wash Valve


DRILLERS REMARKS:

NOV 30 1968

MISS. BO. OF  
 WATER COM.

If well telescopes please sketch and show depths.

GROUND LEVEL

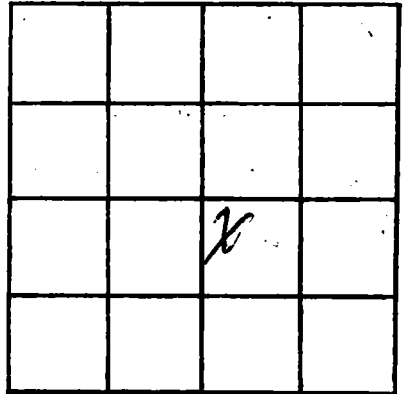

SECTION 29

Please indicate well location X.

ADDITIONAL INFORMATION

If more than one screen, show locations of each on sketch.