

CODED

MISSISSIPPI
BOARD OF WATER COMMISSIONERS
416 North State Street
Jackson, Mississippi 39201

WATER WELL DRILLERS LOG

Jackson
M 84
1-8-65

Jan 2 1965 Belleville Water Sup Jackson
date well completed firm name county well located


LANDOWNER: Johnny
Furby
Billy Orchard Road
(mailing address)

description of formations encountered	from	to
	0	15
Clay	15	60
Gravel	60	78
Clay	78	93
sand	93	225
clay	205	232
sand	232	308
Clay	308	330
sand	330	567
Clay	567	572
sand	572	740
Clay	740	783
sand		

WELL LOCATION:
sec. 14 T-6 N R-5 E
5 miles NE of MP
(distance) (direction) (nearest town)

WELL PURPOSE: home
(home, irrigation, municipal, industrial)


- WELL COMPLETION DATA:
- (1) diameter (inches) 2"
 - (2) total depth (feet) 783
 - (3) static water level (feet) 25 ^{below} _{above} top of ground.
 - (4) casing Galv
(material) (depth)
2" If telescope see back.
(size)
 - (5) screen 10' 773
(length) (depth to top)
2" Stainless
(size) (material)
 - (6) pump no pump
(HP) (yield gpm)
(type power)
 - (7) electric log no
(yes or no)
(organization running log)
 - (8) how well bottom plugged BP/Valve

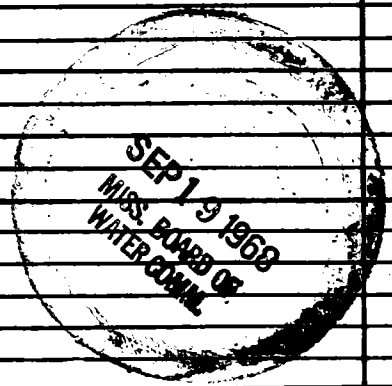

DRILLERS REMARKS:

If well telescopes please sketch and show depths.

GROUND LEVEL

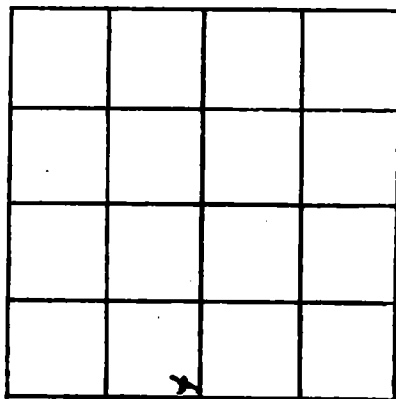

SECTION 14

Please indicate well location X.

ADDITIONAL INFORMATION

If more than one screen, show locations of each on sketch.