

CODED

MISSISSIPPI  
BOARD OF WATER COMMISSIONERS  
416 North State Street  
Jackson, Mississippi 39201

WATER WELL DRILLERS LOG

Jackson  
M 85  
4-6-65

April 6 1965 Obville Watering Jackson  
date well completed firm name county well located


LANDOWNER: Best Fisher  
Belena Miss  
(mailing address)

description of formations encountered	from to	
	feet	feet
clay	0	16
shale	16	18
clay	18	22
sand	22	44
clay	44	292
sand	282	294

WELL LOCATION:  
sec. 26 T 6 N R 5 E  
4 miles NE of MP  
(distance) (direction) (nearest town)

WELL PURPOSE: home  
(home, irrigation, municipal, industrial)


- WELL COMPLETION DATA:
- (1) diameter (inches) 2
  - (2) total depth (feet) 294
  - (3) static water level (feet) 3'4" below above top of ground
  - (4) casing galv (material) (depth)
  - (size) If telescope see back.
  - (5) screen 5 (length) 289 (depth to top)
  - 2' (size) stanley (material)
  - (6) pump (HP) (yield gpm)
  - (type power)
  - (7) electric log no (yes or no)
  - (organization running log)
  - (8) how well bottom plugged OP Valve

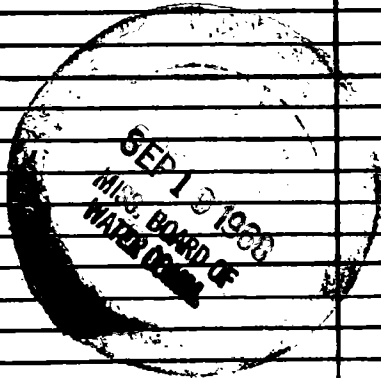

DRILLERS REMARKS:  pump installed by owner

If well telescopes please sketch and show depths.

GROUND LEVEL

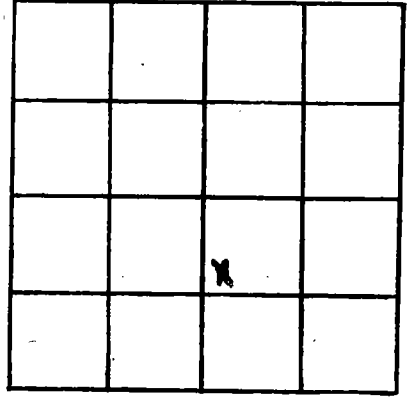

SECTION 26

Please indicate well location X.

ADDITIONAL INFORMATION

If more than one screen,  
show locations of each on sketch.