

**CODED**

MISSISSIPPI  
BOARD OF WATER COMMISSIONERS  
416 North State Street  
Jackson, Mississippi 39201

**WATER WELL DRILLERS LOG**

Jackson  
M 86  
4-22-65

April 22 1965 Colville Water Supply Jackson  
date well completed firm name county well located


LANDOWNER: Sevinity  
Gardens  
Big Point Miss  
(mailing address)

description of formations encountered	from	to
<u>clay</u>	<u>0</u>	<u>26</u>
<u>sand</u>	<u>26</u>	<u>32</u>
<u>clay</u>	<u>32</u>	<u>107</u>
<u>sand</u>	<u>107</u>	<u>118</u>

WELL LOCATION:  
sec 18 T 6 N R 5 E  
6 miles North of MP  
(distance) (direction) (nearest town)

WELL PURPOSE: Cemetery  
(home, irrigation, municipal, industrial)

- WELL COMPLETION DATA:
- (1) diameter (inches) 2
  - (2) total depth (feet) 110
  - (3) static water level (feet) 20.6 <sup>below</sup> above top of ground.
  - (4) casing Galv (material) (depth)  
2" If telescope see back. (size)
  - (5) screen 5 (length) 105 (depth to top)  
2" (size) stainless (material)
  - (6) pump 3/4 (HP) 5 (yield gpm)
  - elec (type power)
  - (7) electric log no (yes or no)
  - (organization running log)
  - (8) how well bottom plugged BP Valve

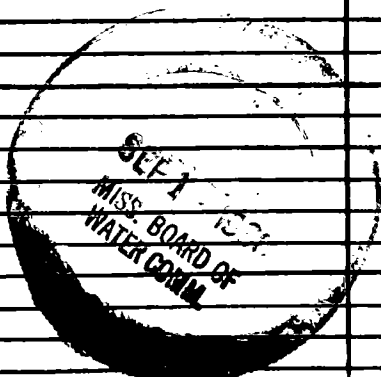

DRILLERS REMARKS:

If well telescopes please sketch and show depths.

GROUND LEVEL

X			

SECTION 18

Please indicate well location X.

**ADDITIONAL INFORMATION**

If more than one screen, show locations of each on sketch.