

Jackson
M 87
12-18-64


MISSISSIPPI
BOARD OF WATER COMMISSIONERS
416 North State Street
Jackson, Mississippi 39201

CODED

WATER WELL DRILLERS LOG


Dec 18 1964 Palmetto Water Supply Jackson
date well completed firm name county well located

LANDOWNER: <u>C. E. Pierce</u>	description of formations encountered	from	to
<u>Helena Miss</u> (mailing address)	<u>clay</u>	<u>0</u>	<u>22</u>
WELL LOCATION: sec. <u>32</u> T. <u>6</u> N. R. <u>5</u> E. <u>5</u> miles <u>NE</u> of <u>MP</u> (distance) (direction) (nearest town)	<u>sand</u>	<u>22</u>	<u>88</u>
WELL PURPOSE: <u>Home</u> (home, irrigation, municipal, industrial)	<u>clay</u>	<u>88</u>	<u>225</u>
WELL COMPLETION DATA: (1) diameter (inches) <u>1 1/4</u> (2) total depth (feet) <u>238</u> (3) static water level (feet) <u>8</u> <u>below</u> top of ground. (4) casing <u>galv</u> (material) (depth) _____ (size) _____ if telescope see back. (5) screen <u>10</u> (length) <u>228</u> (depth to top) <u>1 1/4</u> (size) <u>Copper gauge</u> (material) (6) pump _____ (HP) _____ (yield gpm) (type power) _____ (7) electric log <u>no</u> (yes or no) (organization running log) _____ (8) how well bottom plugged <u>BP Water</u>	<u>sand</u>	<u>225</u>	<u>238</u>
DRILLERS REMARKS: <u>pump installed by owner</u>			

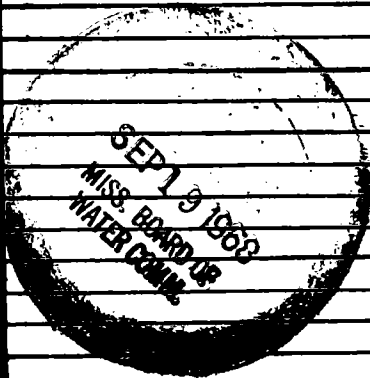

If well telescopes please sketch and show depths.

GROUND LEVEL

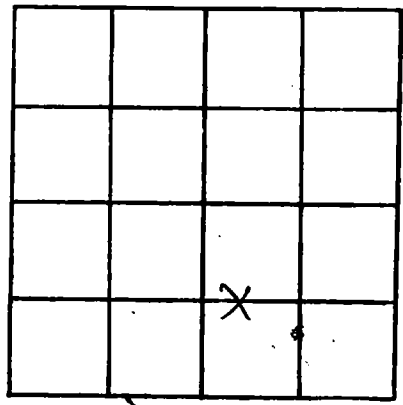

SECTION 32

Please indicate well location X.

ADDITIONAL INFORMATION

A series of horizontal lines for writing additional information, starting below the 'ADDITIONAL INFORMATION' header.

If more than one screen, show locations of each on sketch.