

**MISSISSIPPI  
BOARD OF WATER COMMISSIONERS**  
416 North State Street  
Jackson, Mississippi 39201

**CODED**

**WATER WELL DRILLERS LOG**

Jackson  
M 90  
10-65

Oct 1 1965 Colville Water Sys Jackson  
date well completed firm name county well located

LANDOWNER: <u>Lebe, Leasing</u>	description of formations encountered	from	to
<u>Nickerson</u> (mailing address)	<u>clay</u>	0	10
<b>WELL LOCATION:</b> sec. <u>32</u> T. <u>6</u> N. R. <u>5</u> E. <u>5</u> miles <u>W</u> of <u>Boothville</u> (distance) (direction) (nearest town)	<u>sands</u>	10	78
<b>WELL PURPOSE:</b> <u>home</u> (home, irrigation, municipal, industrial)	<u>clay</u>	78	190
<b>WELL COMPLETION DATA:</b> (1) diameter (inches) <u>1 1/4</u> (2) total depth (feet) <u>204</u> (3) static water level (feet) <u>12</u> <u>below</u> top of ground. (4) casing <u>galv</u> (material), (depth) _____ _____ if telescope see back. (5) screen <u>4</u> (length), <u>200</u> (depth to top) <u>1 1/4</u> (size), <u>Copper Gauge</u> (material) (6) pump _____ (HP), _____ (yield gpm) _____ (type power) (7) electric log <u>no</u> (yes or no) _____ (organization running log) (8) how well bottom plugged <u>BP Valve</u>	<u>sand</u>	190	204
<b>DRILLERS REMARKS:</b> <u>pump installed by owner</u>			


**CODED**

MAR 10 1966

MISS. BD. OF  
WATER COMM.

If well telescopes please sketch and show depths.

GROUND LEVEL

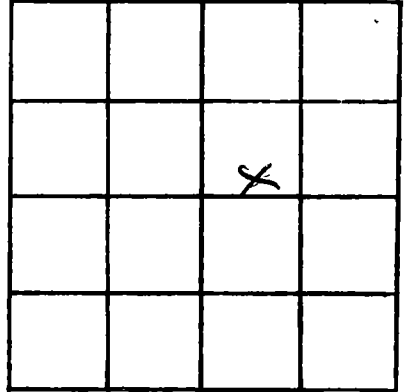

SECTION 32

Please indicate well location X.

ADDITIONAL INFORMATION

If more than one screen,  
show locations of each on sketch.