

**MISSISSIPPI  
BOARD OF WATER COMMISSIONERS**  
416 North State Street  
Jackson, Mississippi 39201

**CODED**

**WATER WELL DRILLERS LOG**

Jackson
M 92
12-65

Dec 2 1965 Colville Water Sup Jackson  
 date well completed firm name county well located

LANDOWNER: Gerald Shonk  
Shonk

description of formations encountered	from	to
<u>clay</u>	<u>0</u>	<u>8</u>
<u>sand</u>	<u>8</u>	<u>90</u>
<u>clay</u>	<u>90</u>	<u>136</u>
<u>sand</u>	<u>136</u>	<u>154</u>

Helena  
 (mailing address)

WELL LOCATION:  
 sec 29 T 6 N R 5 E  
5 miles NE of Bay St Louis  
 (distance) (direction) (nearest town)

WELL PURPOSE: home  
 (home, irrigation, municipal, industrial)

**WELL COMPLETION DATA:**

- (1) diameter (inches) 2"
- (2) total depth (feet) 164
- (3) static water level (feet) 12 <sup>below</sup> top of ground.
- (4) casing Pvc  
 (material) (depth)
- \_\_\_\_\_ If telescope see back.  
 (size)
- (5) screen 4 150  
 (length) (depth to top)
- 2 stainless  
 (size) (material)
- (6) pump \_\_\_\_\_  
 (HP) (yield gpm)
- \_\_\_\_\_ (type power)
- (7) electric log no  
 (yes or no)
- \_\_\_\_\_ (organization running log)
- (8) how well bottom plugged BAU

**CODED**


**MAR 10 1966**

DRILLERS REMARKS: pump installed by other

MISS. BD. OF  
 WATER COMMISSIONERS

If well telescopes please sketch and show depths.

GROUND LEVEL

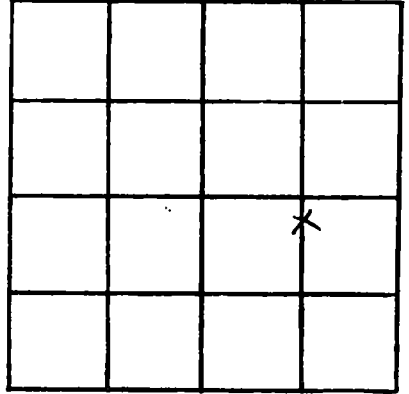

SECTION 2.9

Please indicate well location X.

ADDITIONAL INFORMATION

If more than one screen, show locations of each on sketch.