

Jackson
M 93
12-65

MISSISSIPPI
BOARD OF WATER COMMISSIONERS
416 North State Street
Jackson, Mississippi 39201

CODED

WATER WELL DRILLERS LOG

Dec 6 1965 Charles Water Sup Jac
date well completed firm name county well located

LANDOWNER: D. S. Barfield
Acleva
(mailing address)

WELL LOCATION:
sec 29 T 6 N R 5 E
5 miles NE of Acleva
(distance) (direction) (nearest town)

description of formations encountered	depth	
	from	to
Clay	0	15
sand	15	80
clay	80	258
sand	258	273

WELL PURPOSE: home
(home, irrigation, municipal, industrial)

- WELL COMPLETION DATA:
- (1) diameter (inches) 2
 - (2) total depth (feet) 273
 - (3) static water level (feet) 6 ^{below} above top of ground.
 - (4) casing galv (material), (depth) _____
_____ if telescope see back.
(size)
 - (5) screen 5 268
(length) (depth to top)
2" stainless
(size) (material)
 - (6) pump _____ (HP) _____ (yield gpm)
(type power)
 - (7) electric log no (yes or no)
(organization running log)
 - (8) how well bottom plugged BPU


R 10 1965

DRILLERS REMARKS: pump installed by others

MISS. BD. OF
WATER COMM.

If well telescopes please sketch and show depths.

GROUND LEVEL

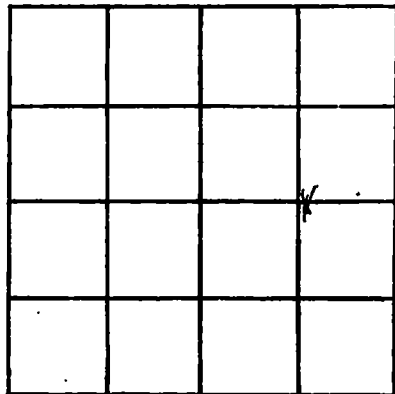

SECTION 29

Please indicate well location X.

ADDITIONAL INFORMATION

If more than one screen, show locations of each on sketch.