

**MISSISSIPPI
BOARD OF WATER COMMISSIONERS**
416 North State Street
Jackson, Mississippi 39201

CODED

WATER WELL DRILLERS LOG

Jackson
M94
12-65

Dec 28 1965 Corville Water Supply Co. Ja.
date well completed firm name county well located

LANDOWNER: J. D. Broadus
Helena
(mailing address)

WELL LOCATION:
sec. 15 T. 6 N. R. 5 E
1 miles N of Moss Point
(distance) (direction) (nearest town)

| description of formations encountered | from | to |
|---------------------------------------|------------|------------|
| <u>Clay</u> | <u>2</u> | <u>15</u> |
| <u>sand</u> | <u>15</u> | <u>140</u> |
| <u>Clay</u> | <u>140</u> | <u>268</u> |
| <u>sand</u> | <u>268</u> | <u>339</u> |

WELL PURPOSE: home
(home, irrigation, municipal, industrial)

WELL COMPLETION DATA:

(1) diameter (inches) 2"

(2) total depth (feet) 339

(3) static water level (feet) 9 1/2 below top of ground. above

(4) casing galv (material), (depth)

(size) if telescope see back.

(5) screen 5' 334 (length), (depth to top)
2" stainless (size), (material)

(6) pump (HP) (yield gpm)
(type power)

(7) electric log no (yes or no)
(organization running log)

(8) how well bottom plugged BPU

CODED


MAR 10 1969

DRILLERS REMARKS: pump installed by others

MISS. BD. OF
WATER COMM.

If well telescopes please sketch and show depths.

GROUND LEVEL

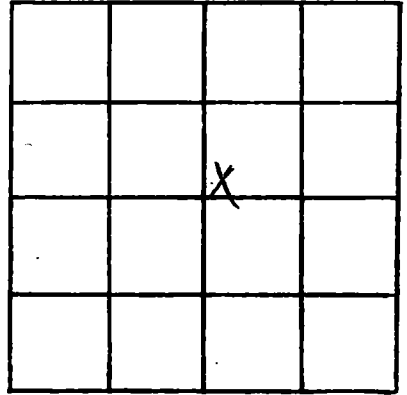

SECTION 15

Please indicate well location X.

ADDITIONAL INFORMATION

If more than one screen, show locations of each on sketch.