

CODED

MISSISSIPPI
BOARD OF WATER COMMISSIONERS
416 North State Street
Jackson, Mississippi 39201

WATER WELL DRILLERS LOG

Jackson
M95
4-28-66

April 28 1966 B.P. Caldwell Water Supply Jackson
date well completed firm name county well located


LANDOWNER: <u>D. O. McCallum</u>	description of formations encountered	from	to
<u>Helmus, Miss.</u> (mailing address)			
		<u>22</u>	<u>58</u>
WELL LOCATION:			
sec. <u>34</u> T. <u>6</u> N. R. <u>5</u> E. of <u>Mass Point</u>			
<u>6</u> miles <u>NE</u> (direction) of <u>Mass Point</u> (nearest town)			
WELL PURPOSE: (home, irrigation, municipal, industrial)			
WELL COMPLETION DATA:			
(1) diameter (inches) <u>14 1/2"</u>			
(2) total depth (feet) <u>58'</u>			
(3) static water level (feet) <u>9</u> <u>below</u> top of ground.			
(4) casing <u>galv</u> (material), (depth)			
(size) If telescope see back.			
(5) screen <u>5'</u> <u>53'</u> (length) (depth to top)			
<u>14 1/2"</u> (size), <u>plastic</u> (material)			
(6) pump (HP) (yield gpm)			
(type power)			
(7) electric log <u>no</u> (yes or no)			
(organization running log)			
(8) how well bottom plugged <u>B.P. Caldwell</u>			
DRILLERS REMARKS: <u>pump inst. by owner</u>			

APR 21 1966

MISS. BD. OF
WATER COM.

If well telescopes please sketch and show depths.

GROUND LEVEL

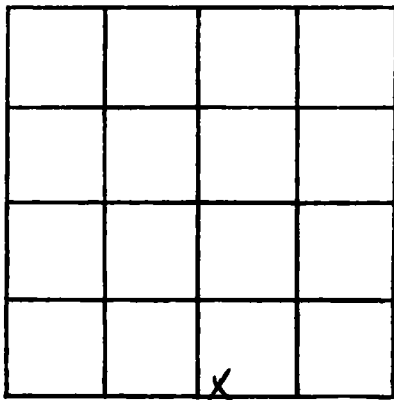

SECTION 34

Please indicate well location X.

ADDITIONAL INFORMATION

Lined area for additional information.

If more than one screen, show locations of each on sketch.