

**MISSISSIPPI
BOARD OF WATER COMMISSIONERS**
416 North State Street
Jackson, Mississippi 39201

CODED

WATER WELL DRILLERS LOG

Jackson
M 96
5-10-66

May 10 1966 Colville Water Supply Jackson
date well completed firm name county well located

LANDOWNER: <u>Mrs. Jennie Clark</u>	description of formations encountered	from	to
<u>Forto Lake</u> (mailing address)	<u>clay</u>	<u>0</u>	<u>15</u>
WELL LOCATION: sec. <u>18</u> T. <u>6</u> N. R. <u>4</u> E. W. <u>12</u>	<u>sand</u>	<u>15</u>	<u>35</u>
<u>12</u> miles <u>NE</u> of <u>MOSS POINT</u> (distance) (direction) (nearest town)	<u>clay</u>	<u>35</u>	<u>66</u>
WELL PURPOSE: <u>house</u> (home, irrigation, municipal, industrial)	<u>sand</u>	<u>66</u>	<u>88</u>
WELL COMPLETION DATA:			
(1) diameter (inches) <u>2"</u>			
(2) total depth (feet) <u>88</u>			
(3) static water level (feet) <u>30</u> <u>below</u> top of ground.			
(4) casing <u>galv</u> (material) (depth)			
(size) If telescope see back.			
(5) screen <u>5'</u> (length) <u>83</u> (depth to top)			
<u>2"</u> (size) <u>plastic</u> (material)			
(6) pump (HP) (yield gpm)			
(type power)			
(7) electric log <u>no</u> (yes or no)			
(organization running log)			
(8) how well bottom plugged <u>B.P. Vahy</u>			
DRILLERS REMARKS: <u>pump installed by owner</u>			


CODED

APR 21 1969

MISS. BD. OF
WATER COMM.

If well telescopes please sketch and show depths.

GROUND LEVEL

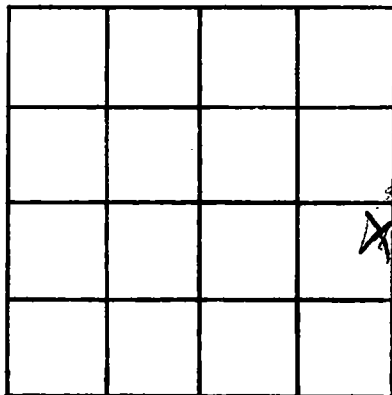

SECTION 18

Please indicate well location X.

ADDITIONAL INFORMATION

If more than one screen, show locations of each on sketch.