

Jackson
M 101
8-2-66

MISSISSIPPI
BOARD OF WATER COMMISSIONERS
416 North State Street
Jackson, Mississippi 39201
WATER WELL DRILLERS LOG

Aug 2 1966 Cobble Water Supply Jackson
d. well completed firm name County well located


LANDOWNER: Frank Wise	description of formations encountered	from	to
Helena Miss (mailing address)	Clay	0	22
WELL LOCATION: sec. 33 T 6 N R 5 E 5 miles N of Moss Point	sand	22	82
WELL PURPOSE: home (home, irrigation, municipal, industrial)	Clay	198	198
WELL COMPLETION DATA:	sand	198	219
(1) diameter (inches) 2"			
(2) total depth (feet) 219			
(3) static water level (feet) 8 below above top of ground.			
(4) casing Galv (material) (depth)			
(size) If telescope see back.			
(5) screen 5 214 (length) (depth to top)			
2" stainless (size) (material)			
(6) pump (HP) (yield gpm)			
(type power)			
(7) electric log no (yes or no)			
(organization running log)			
(8) how well bottom plugged BP Wiley			
DRILLERS REMARKS: Pump installed by owner			

APR 21 1969

MISS. BD. OF WATER COMM.

If well telescopes please sketch and show depths.

GROUND LEVEL

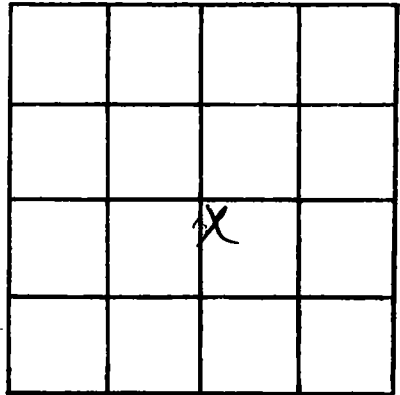

SECTION 33

Please indicate well location X.

ADDITIONAL INFORMATION

Lined area for additional information.

If more than one screen, show locations of each on sketch.