

Jackson  
 M103  
 10-11-66

MISSISSIPPI  
 BOARD OF WATER COMMISSIONERS  
 416 North State Street  
 Jackson, Mississippi 39201

CODED

WATER WELL DRILLERS LOG

Oct 11 1966 well completed  
 Mobile Water Supply firm name  
 Jackson County well located


LANDOWNER: <u>M.S. Crimm</u>	description of formations encountered	from	to
<u>Rt. 3 Box 398</u>			
<u>Pass (Dodge city)</u> (mailing address)	<u>Clay</u>	<u>0</u>	<u>10</u>
	<u>sand</u>	<u>10</u>	<u>66</u>
	<u>Clay</u>	<u>64</u>	<u>100</u>
	<u>sand</u>	<u>104</u>	<u>211</u>
WELL LOCATION: sec. <u>3</u> T. <u>6</u> N. R. <u>5</u> E <u>8</u> miles <u>NE</u> of <u>More Point</u> (distance) (direction) (nearest town)			
WELL PURPOSE: <u>Home</u> (home, irrigation, municipal, industrial)			
WELL COMPLETION DATA:			
(1) diameter (inches) <u>2</u>			
(2) total depth (feet) <u>211</u>			
(3) static water level (feet) <u>11</u> <sup>below</sup> above top of ground.			
(4) casing <u>Galv</u> (material) (depth) _____ (size) if telescope see back.			
(5) screen <u>5'</u> (length) <u>206</u> (depth to top) <u>2"</u> (size) <u>Stainless</u> (material)			
(6) pump _____ (HP) _____ (yield gpm) (type power)			
(7) electric log <u>no</u> (yes or no) (organization running log)			
(8) how well bottom plugged <u>OP Valve</u>			
DRILLERS REMARKS: <u>Pump installed by owner</u>			

APR 21 1969

MISS. BD. OF  
 WATER COMM.

If well telescopes please sketch and show depths.

GROUND LEVEL

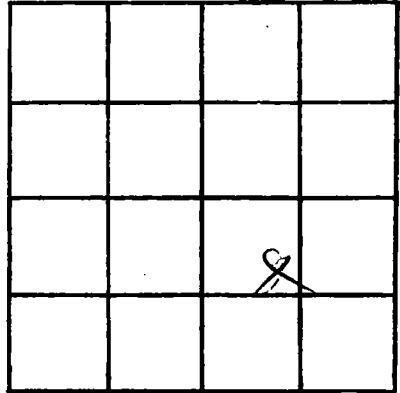

SECTION

33

Please indicate well location X.

ADDITIONAL INFORMATION

If more than one screen,  
show locations of each on sketch.